IREDELL COUNTY HEALTH DEPARTMENT

STATESVILLE 704-878-5305 (C) MOORESVILLE 704-664-5281

IMPROVEMENT PERMIT / AUTHORIZATION TO CONSTRUCT / OPERATION PERMIT / EXISTING SYSTEM INSPECTION

PERMIT# 111601 PIN# 4779-27-~~7895~~ 7677 DATE 5-1-03

OWNER OR CONTRACTOR STEVEN R. LAWS PHONE: Business Home 704-876-4837

ADDRESS 177 COUNTRY VIEW ROAD, STATESVILLE, NC 28625

LOCATION US 21 NORTH, TR BETHEL ROAD, TR ARROWBROOK ROAD, 0.2 MILE ON RIGHT

SUBDIVISION BLOCK / SECTION LOT LOT AREA 2.5 ACRES SITE CLASS PS DESIGN FLOW 360 L.T.A.R. 0.30 GPA/FT²

Septic Tank: 1000 Gallons; STB 1012 Date 11-19-02
Pump Tank: Gallons; PT Date
Pump Make: Model Serial No.
Nitrification Field: No Fields 1 Square Feet 1200 Linear Feet 400
No Lines FOUR Trench Width 36" Max Trench Bottom Depth 36" Gravel Depth 12"

☑ New System ☐ Repair System Type: I (II) III, IV, V, VI
System Description: CONVENTIONAL, GRAVITY
Repair System Description: CONVENTIONAL, GRAVITY
Maintenance Agreement Required: ☐ Yes ☑ No


☐ House/Mod. Home No. Bedrooms 3
☑ Mobile Home No. Bathrooms 2
☐ Business No. Employees
☐ Other
☐ Slab ☑ Crawl Space ☐ Basement w/plumbing ☐ Basement wo/plumbing

Water Supply: ☑ Individual ☐ Public ☐ Community


Comments:/Conditions ① INSTALL SUBSURFACE INTERCEPT DRAINAGE DITCH AT LOCATION SHOWN BEGINNING 38" DEEP AROUND SYSTEM OUT TO DAYLIGHT ② INSTALL LINES NO DEEPER THAN 26" DEEP

Comments:/Conditions ① SYSTEM ALTERED AS SHOWN BELOW ② SEPTIC TANK WITH MARKER INSTALLED USING "~~FILTERITE~~" "TUFFITE" FILTER

INITIAL SITE SKETCH

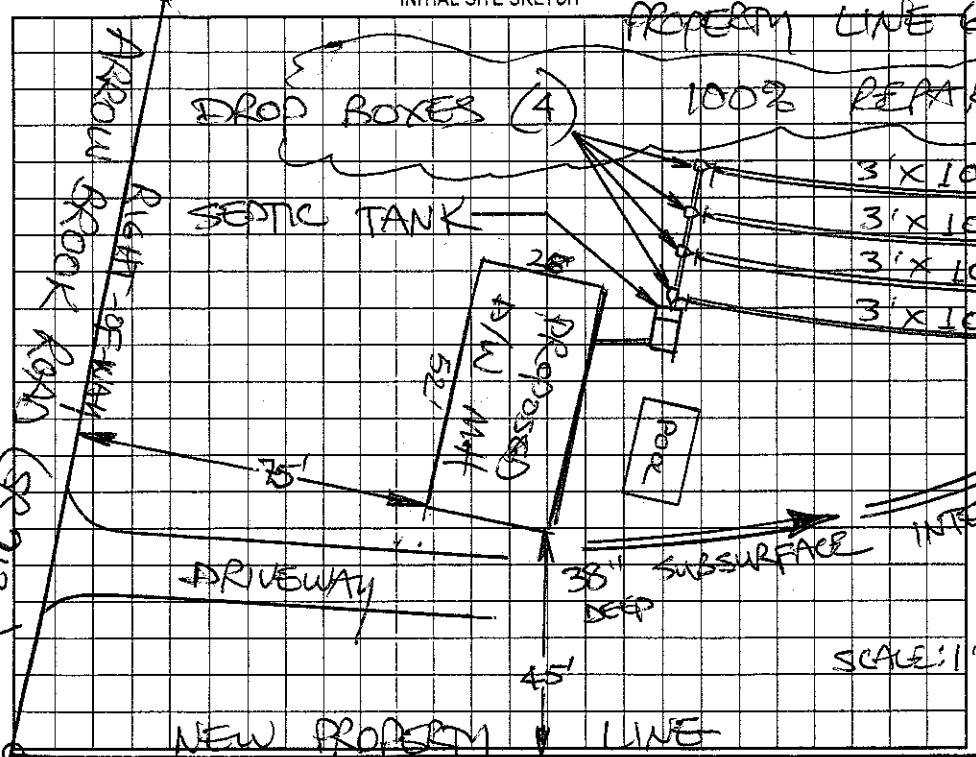

AS BUILT SKETCH

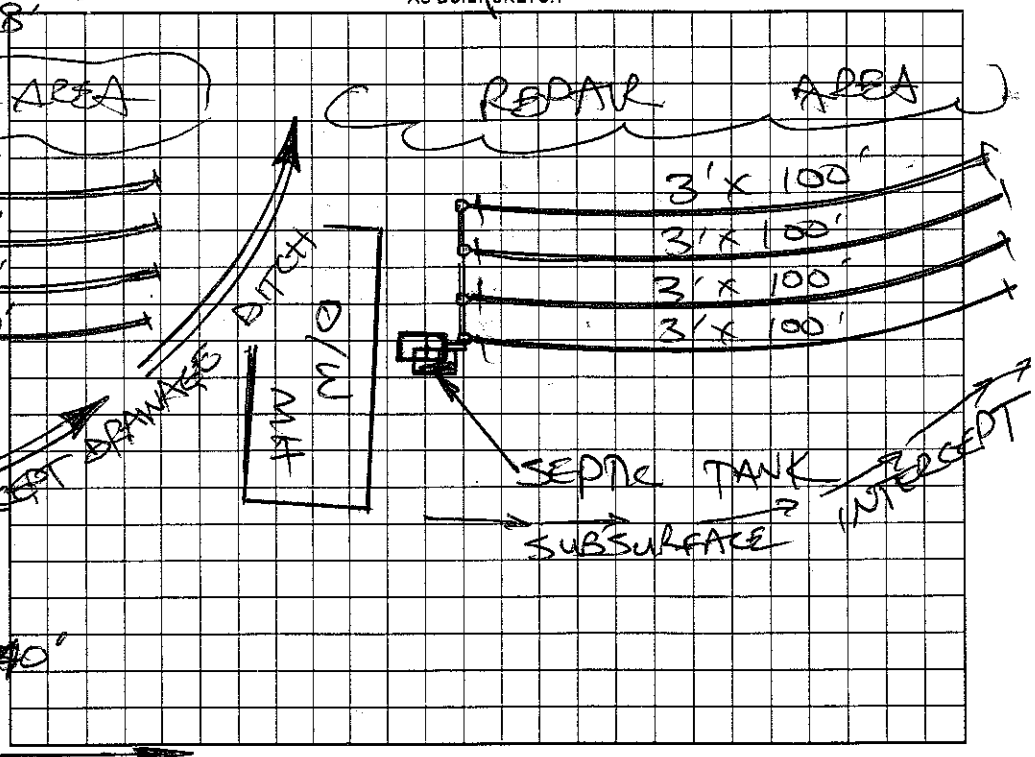

Permit can be suspended or revoked if any false information is supplied toward securing the permit/any unauthorized changes are made to the site/any unauthorized changes are made in the installation of the system. Improvement Permit with plat valid without expiration. Improvement Permit with site plan valid for sixty months. Authorization to Construct is valid for a period equal to that of Improvement Permit – not to exceed sixty months.

Signed: Matthew Ralph Fowler date 5-1-03 Installed by: TOMMY FRYE

Improvement Permit by: STEVE HEDRICK date 5-1-03 Operation Permit by: STEVE HEDRICK date 6-10-03

Authorization to Construct by: STEVE HEDRICK date 5-1-03 Existing System Inspection by: date

HEALTH DEPT. COPY: WHITE OWNER COPY (FINAL): YELLOW OWNER COPY (INITIAL): PINK