IREDELL COUNTY HEALTH DEPARTMENT

Statesville Office (704) 878-5305 Mooresville Office (704) 660-3625 PERMIT # 178129

IMPROVEMENT PERMIT / AUTHORIZATION TO CONSTRUCT / OPERATION PERMIT / EXISTING SYSTEM

PIN # 4779287613

APPLICANT: Sanford Hedrick APPLICANT ADDRESS: 2951 Harmony Hwy

SITE ADDRESS: 2875 Harmony Hwy PHONE: 704-546-7355 ALT. PHONE: N/A

SITE DIRECTIONS: Hwy 21 N Site on left just before Mt. Bethel Rd.

SUBDIVISION: N/A SECTION: N/A LOT # N/A LOT AREA: 2.2 acres DESIGN FLOW: 360 gpd L.T.A.R.: 0.3

Septic Tank Existing (gal) STB Date

Pump Tank (gal) PT Date

Pump Make Model Serial #

Nitrification Fields 1 # Lines 1 Linear Ft: 100

Trench Width 36" Max. Trench Bottom Depth 36" Gravel Depth N/A

☐ New System ☐ Repair ☑ Expansion System Type: I II (III) IV V VI

System Description: 75% Reduction

Repair System Description: 25% Reduction

Maintenance Agreement Required: ☐ YES ☑ NO

☑ GRAVITY ☐ PRESSURE

☑ Residence No. Bedrooms 3

☐ Business No. Persons

☐ Other No. Employees

☐ Slab ☑ Crawl Space

☐ Basement w/plumbing ☐ Basement w/o plumbing

Water Supply


☐ Private

☑ Public


☐ Community

Comments / Conditions: Install 100' of 25% Reduction system on contour with serial distribution and connect to existing drainfield with D-boxes as shown below.

INITIAL SITE SKETCH

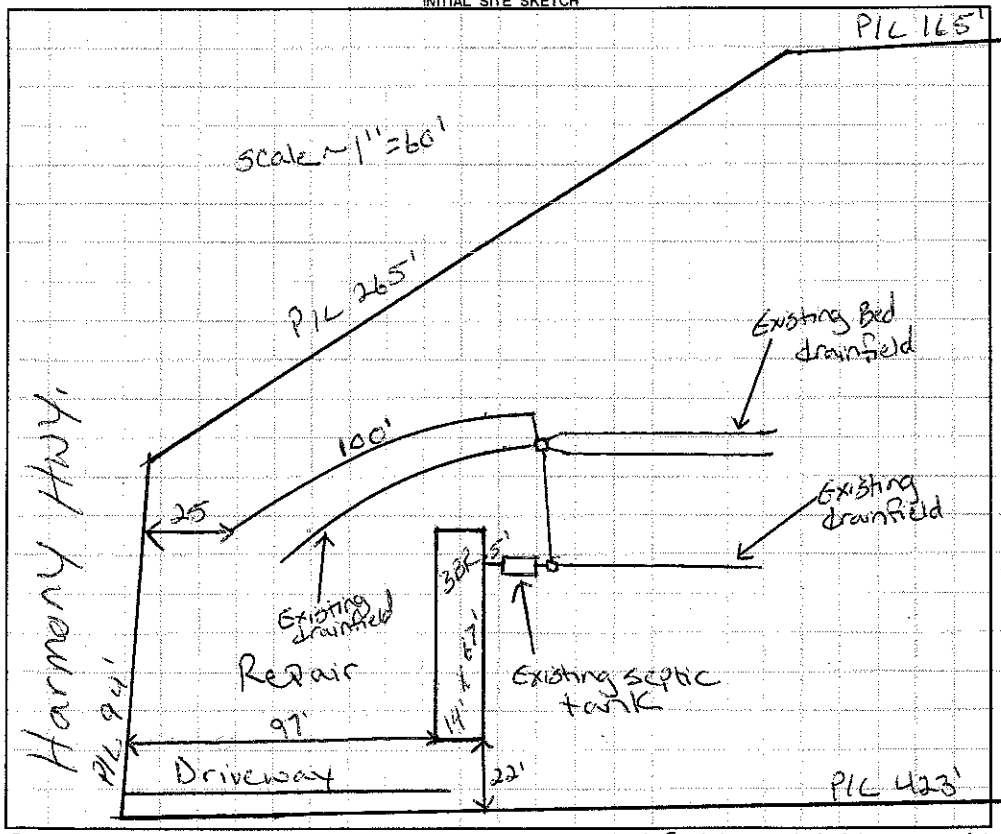

AS BUILT SKETCH

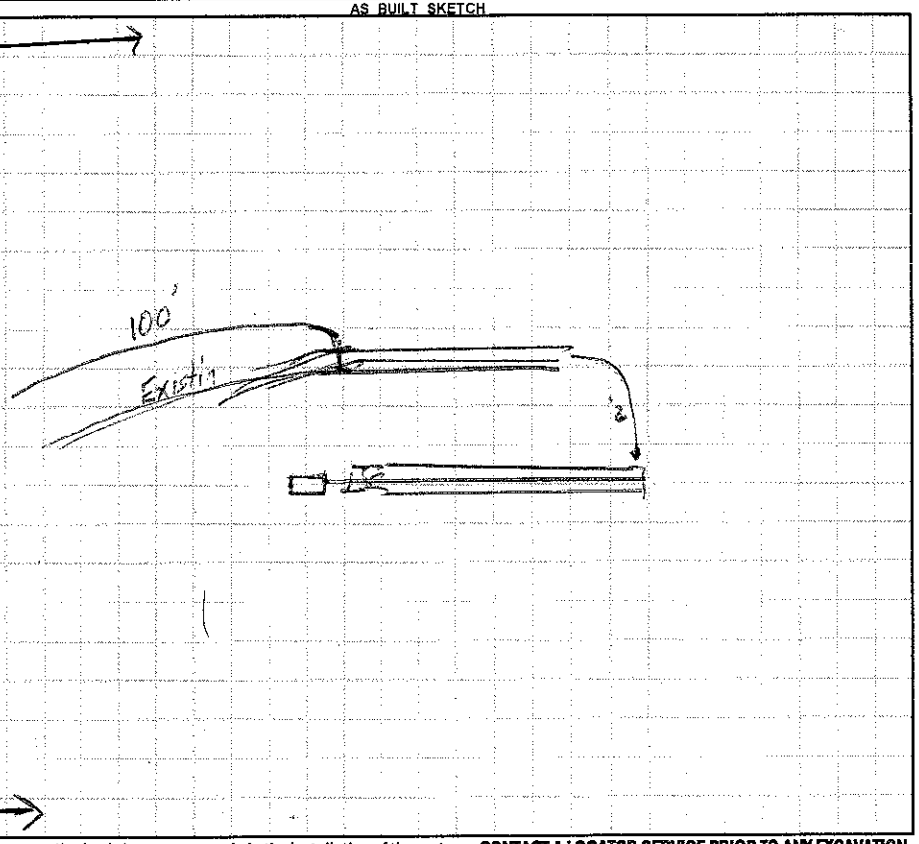

Permit can be suspended or revoked if any false information is supplied toward securing the permit / any unauthorized changes are made to the site / any unauthorized changes are made in the installation of the system. **CONTACT A LOCATOR SERVICE PRIOR TO ANY EXCAVATION**

☐ **IMPROVEMENT PERMIT** *with plat valid without expiration.* ☑ **IMPROVEMENT PERMIT** *with site plan valid for 60 mos.* ☑ **AUTHORIZATION TO CONSTRUCT** *valid for period equal to IMPROVEMENT PERMIT--not to exceed 60 mo.*

Owner / Applicant Signature: Ed Hedrick Date: 5/6/13 Installed by: Tommy Frye

IMPROVEMENT PERMIT by: Justin Henderson Date: 5-3-13 OPERATION PERMIT by: Date: 5-13-13

AUTHORIZATION TO CONSTRUCT by: Justin Henderson Date: 5-3-13 Existing System Inspected by: Date:

Health Dept. Copy - WHITE Applicant (Final Approval) - YELLOW Applicant (Conditional Approval) - PINK