IREDELL COUNTY HEALTH DEPARTMENT

STATESVILLE 704-878-5305 MOORESVILLE 704-664-5281

IMPROVEMENT PERMIT / AUTHORIZATION TO CONSTRUCT / OPERATION PERMIT / EXISTING SYSTEM INSPECTION

PERMIT# REPAIR PIN# 4779-28-9183 DATE 5-16-2006

OWNER OR APPLICANT SUZIE LAWS PHONE: Business Home 704-546-7965

ADDRESS 2870 HARMONY HWY, HARMONY NC 28634

LOCATION US 21 NORTH, ON RIGHT AT MT. BETHEL ROAD

SUBDIVISION BLOCK / SECTION LOT LOT AREA 5.3 ACRES SITE CLASS. PS DESIGN FLOW 360 L.T.A.R. 0.30 GPD/FT2

Septic Tank: EXISTING Gallons: STB Date

Pump Tank: Gallons: PT Date

Pump Make: Model Serial No.

Nitrification Field: No Fields 1 Square Feet 270 Linear Feet 90

No Lines ONE Trench Width 36" Max Trench Bottom Depth 36+/- Gravel Depth 24" ☑ Gravity ☐ Pressure

☐ New System ☑ Repair ☐ Expansion System Type: I (II) III IV V VI

System Description:

Repair System Description: CONVENTIONAL, GRAVITY

Maintenance Agreement Required: ☐ Yes ☑ No

☑ House/Mod. Home No. Bedrooms 3

☐ Mobile Home No. Persons

☐ Business No. Employees

☐ Other


☐ Slab ☑ Crawl Space ☐ Basement w/plumbing ☐ Basement wo/plumbing

Water Supply: ☐ Individual ☑ Public ☐ Community

Comments:/Conditions: INSTALL NEW 3' X 90' DRAINLINE AS FLAGGED USING 24" STONE. FEED NEW LINE FIRST.

Comments:/Conditions:

INITIAL SITE SKETCH

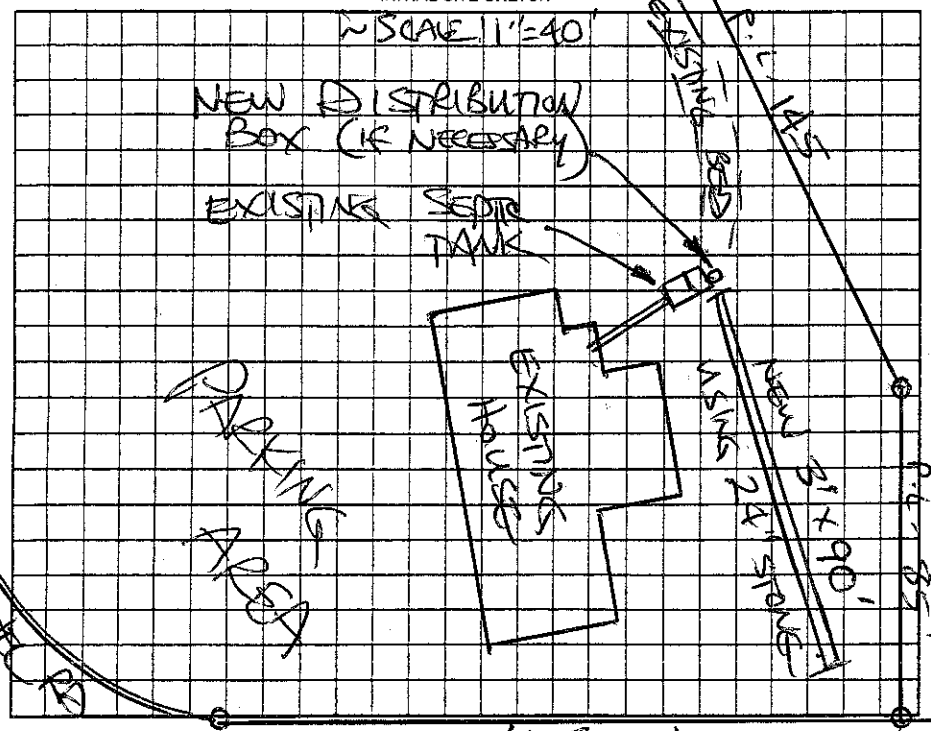

AS BUILT SKETCH

Permit can be suspended or revoked if any false information is supplied toward securing the permit/any unauthorized changes are made to the site/any unauthorized changes are made in the installation of the system. Improvement Permit with plat valid without expiration ☐ Improvement Permit with site plan valid for sixty months ☐ Authorization to Construct is valid for a period equal to that of Improvement Permit – not to exceed sixty months.

Signed: date 5-16-2006 Installed by: DAVID WINBORNE

Improvement Permit by: STEVE HEDRICK date 5-16-2006 Operation Permit by: date 5-31-06

Authorization to Construct by: STEVE HEDRICK date 5-16-2006 Existing System Inspection by: date

HEALTH DEPT. COPY: WHITE OWNER COPY (FINAL): YELLOW OWNER COPY (INITIAL): PINK