IREDELL COUNTY HEALTH DEPARTMENT

STATESVILLE 704-878-5305 MOORESVILLE 704-664-5281

IMPROVEMENT PERMIT / CERTIFICATE OF COMPLETION / OPERATION PERMIT / EXISTING SYSTEM INSPECTION

PROPERTY DESCRIPTION NO. REPAIR DATE 6/21/93 TAX MAP NO.

OWNER OR CONTRACTOR TONY LAWS PHONE: Business 546-7965 Home

ADDRESS Rt. 1, Box 225, Harmony, 28634

LOCATION US 21 N, ON (R) AT SOUTH EAST CORNER OF BETHEL ROAD INTERSECTION

SUBDIVISION BLOCK / SECTION LOT LOT AREA AMPLE SITE CLASS. P5 L.T.A.R. 0.3 GAD/FT2

Water Supply: ☐ Individual ☐ Community ☑ Public

Septic Tank: ~~1000~~ Gallons; STB 620 Date 5-4-93

Pump Tank: — Gallons; PT — Date —

Nitrification Field: No Fields 1 Square Feet 720 Linear Feet 120

No Lines 1 Trench Width 72" Trench Depth 36" Gravel Depth 18"

☐ New System ☑ Repair System Type: I, II, III, IV, V, VI

System Description: CONV. GRAVITY

Repair System Description: CONV. GRAVITY

Maintenance Agreement Required: ☐ Yes ☑ No

☑ House/Mod. Home No. Bedrooms 3 Garbage Disposal: ☐ Yes ~~☐ No~~

☐ Mobile Home No. Bathrooms 2 Auto. Dishwasher: ☑ Yes ☐ No

☐ Business No. Employees Auto. Washing Machine: ☑ Yes ☐ No


☐ Other Other

☐ Slab ☑ Crawl Space ☐ Basement w/plumbing ☐ Basement wo/plumbing


Comments ① CHECK SEPTIC TANK FOR INTEGRITY, REPLACE SANITARY TEE IF NECESSARY ② INSTALL NEW 6'x120' BED AS SHOWN ON CONTOUR USING 18" STONE.

Installed new septic Tank, installed 6' x 140' Bed.

INITIAL SITE SKETCH

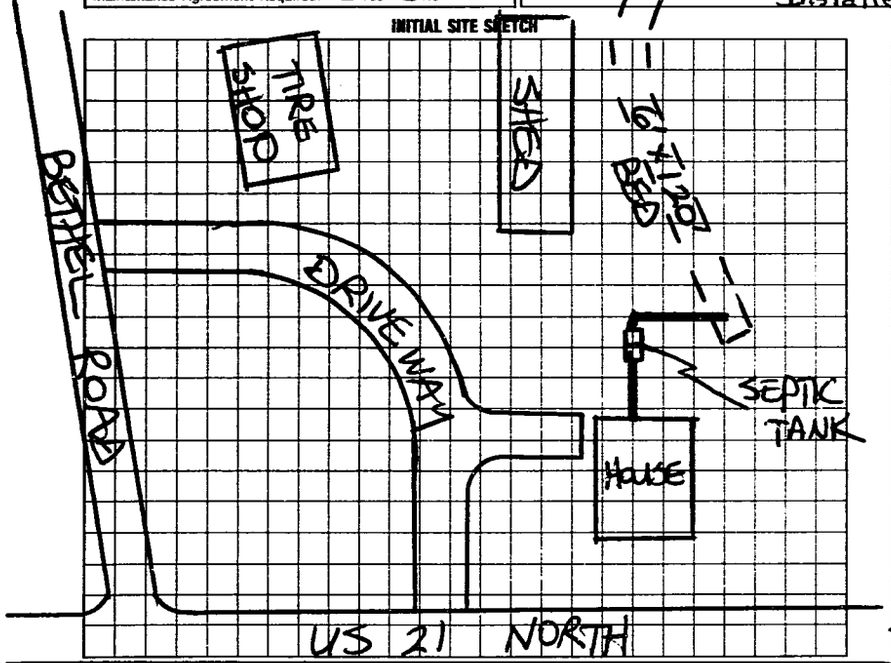

AS BUILT SKETCH

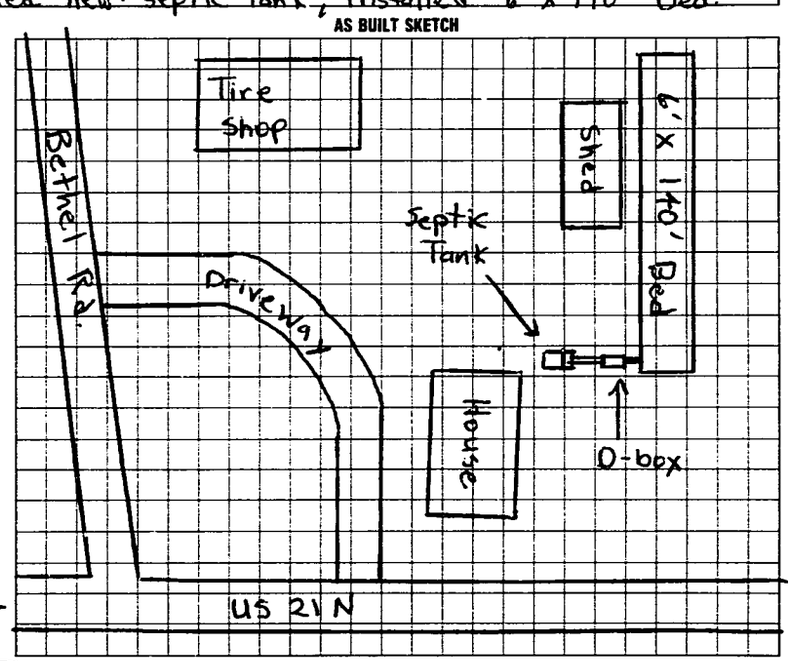

I understand that this permit can be suspended or revoked if any false information is supplied toward securing the permit/any unauthorized changes are made to the site/any unauthorized changes are made in the installation of the system. Improvement Permit is valid for 60 months from date of issuance.

Signed: X

Improvement Permit by: STEVE HERRICK date 6/21/93

Existing System Inspection by: date

Installed by: LARRY POWELL

Certificate of Completion by: Michael J. Dennis date 6-23-93

Operation Permit by: date

HEALTH DEPT. COPY: WHITE INSPECTION COPY (FINAL): GREEN OWNER COPY (FINAL): YELLOW INSPECTION COPY (INITIAL): PINK OWNER COPY (INITIAL): GOLD