IREDELL COUNTY HEALTH DEPARTMENT

STATESVILLE 704-878-5305 MOORESVILLE 704-664-5281

IMPROVEMENT PERMIT / AUTHORIZATION TO CONSTRUCT / OPERATION PERMIT / EXISTING SYSTEM INSPECTION

PERMIT # 157774 PIN # 4779349073 DATE 8-20-09

OWNER or APPLICANT Amanda Singleton PHONE: Business Home:

OWNER or APPLICANT ADDRESS 289 Marshall Farm RD Harmony NC 28634

LOCATION / DIRECTIONS 21 N (R) Mt Bethel (R) Marshall Farm RD at end on left (289 Marshal Farm)

SUBDIVISION BLOCK / SECTION LOT # LOT AREA 1.09 DESIGN FLOW 240 L.T.A.R. 0.8

Septic Tank Exist 1000 Gallons: STB Date

Pump Tank Gallons: P T Date

Pump Make Model Serial #

Nitrification Field No Fields No Lines Linear Feet Exist

Trench Width Does Max. Trench Bottom Depth Exist Gravel Depth Exist

☑ ~~New System~~ Exist ☐ Repair ☐ Expansion System Type I II III IV V VI

System Description: Conventional Gravity

Repair System Description: 2520 Gravity

Maintenance Agreement Required ☐ YES ☐ NO

☐ GRAVITY ☐ PRESSURE

☑ Residence No. Bedrooms 2

☐ Business No. Persons

☐ Other No. Employees

☐ Slab ☐ ~~Crawl~~ Space

☐ Basement w/plumbing ☐ Basement w/o plumbing


Water Supply: ☐ Private ☐ Public ☐ Community

Comments / Conditions

Comments / Conditions

INITIAL SITE SKETCH

AS BUILT SKETCH

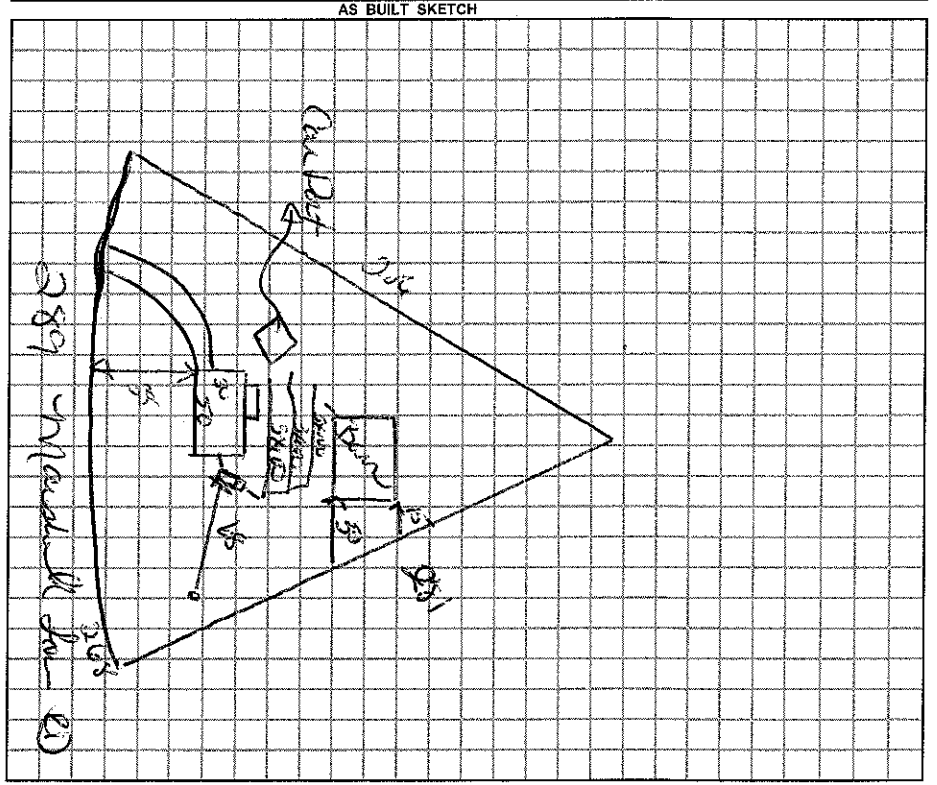

Permit can be suspended or revoked if any false information is supplied toward securing the permit / any unauthorized changes are made to the site / any unauthorized changes are made in the installation of the system.

☐ *IMPROVEMENT PERMIT w / plat valid without expiration* ☐ *IMPROVEMENT PERMIT w / site plan valid for 60 mos.* ☑ *AUTHORIZATION TO CONSTRUCT valid for period equal to IMPROVEMENT PERMIT-not to exceed 60 mo.*

Owner / Applicant Signature: Date 8-21-09

Improvement Permit by: Date

Authorzation to Construct by: Date

YOU SHOULD CONTACT A LOCATOR SERVICE PRIOR TO ANY EXCAVATION.

Installed by:

Operation Permit by: Date:

Existing System Inspected by: Date: 8-20-09

WHITE COPY Environmental Health YELLOW COPY (Final) Owner / Applicant PINK COPY (Initial) Owner / Applicant