IREDELL COUNTY HEALTH DEPARTMENT

STATESVILLE 704-878-5305 MOORESVILLE 704-664-5281

IMPROVEMENT PERMIT / AUTHORIZATION TO CONSTRUCT / OPERATION PERMIT / EXISTING SYSTEM INSPECTION

PERMIT # 156953 PIN # 4779-37-3872 DATE 7-24-09

OWNER or APPLICANT Michael Pope PHONE: Business 704-903-8664 Home: 704-878-2547

OWNER or APPLICANT ADDRESS 12 Arrowbrook Rd Harmony

LOCATION / DIRECTIONS 21N (R) Mt Bethel (R) Arrowbrook

SUBDIVISION BLOCK / SECTION LOT # LOT AREA .69 DESIGN FLOW 360 L.T.A.R. .25

Septic Tank Exist Gallons: STB Exist Date Exist

Pump Tank Gallons: P T Date

Pump Make Model Serial #

Nitrification Field No Fields No Lines 4+3 Linear Feet 120

Trench Width 36" Max. Trench Bottom Depth 36" Gravel Depth NA

☑ New System ☐ Repair ☐ Expansion System Type I II (III) IV V VI

System Description: Exist +25%

Repair System Description: 50% Low Pres

Maintenance Agreement Required ☐ YES ☑ NO

☑ GRAVITY ☐ PRESSURE

☑ Residence No. Bedrooms 3

☐ Business No. Persons

☐ Other No. Employees

☐ Slab ☐ Crawl Space

☐ Basement w/plumbing ☐ Basement w/o plumbing


Water Supply ☐ Private ☑ Public ☐ Community

Comments / Conditions


Install on Contour
Maintain all Setbacks

Comments / Conditions

INITIAL SITE SKETCH

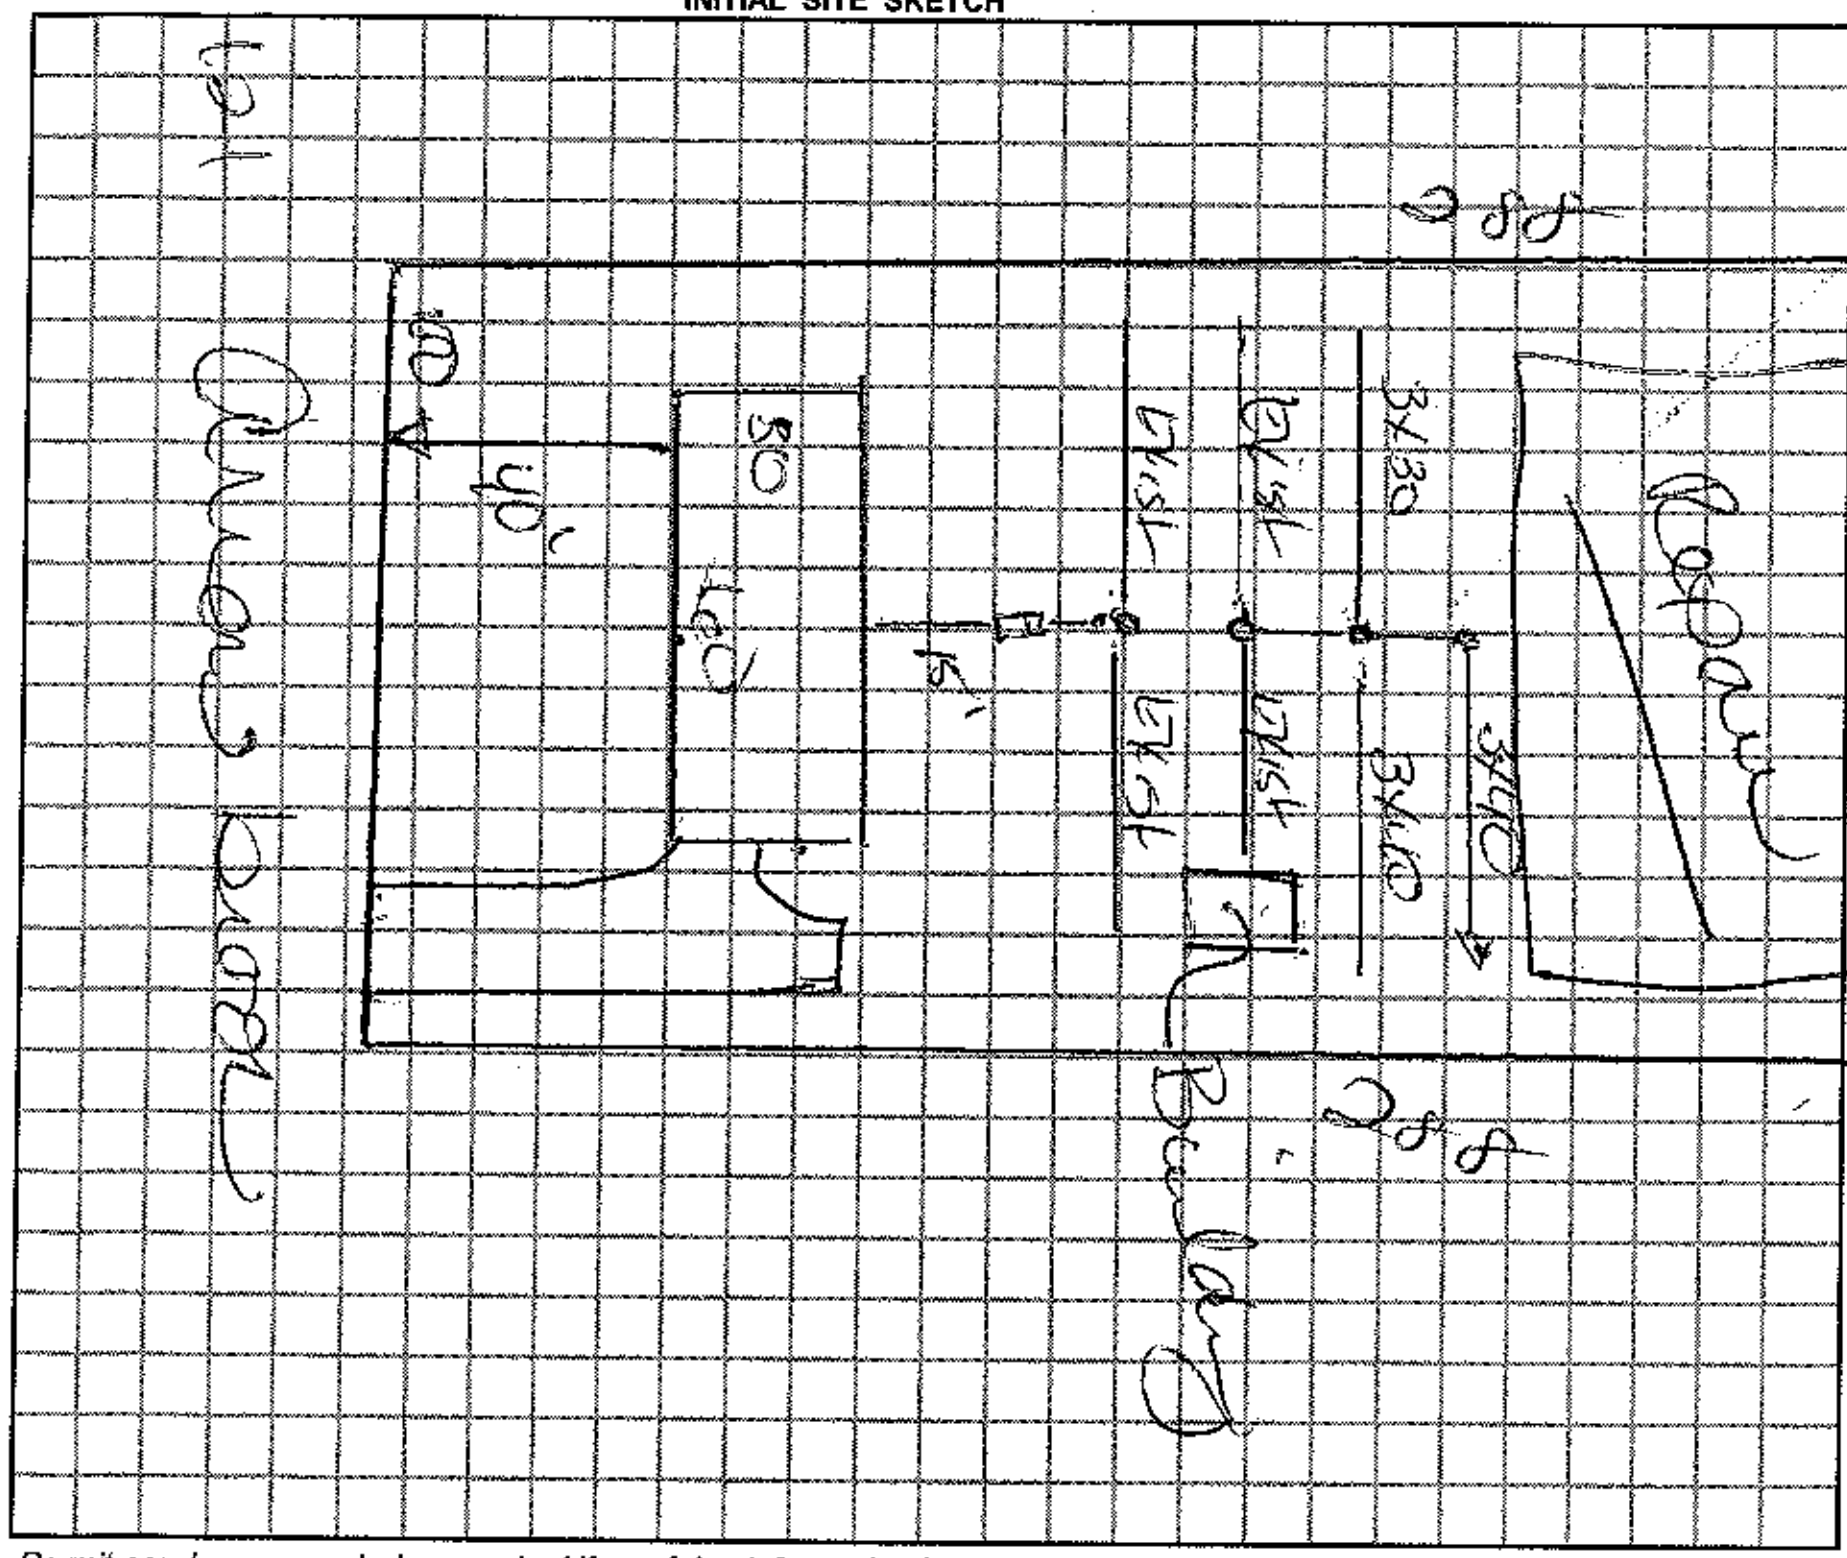

AS BUILT SKETCH

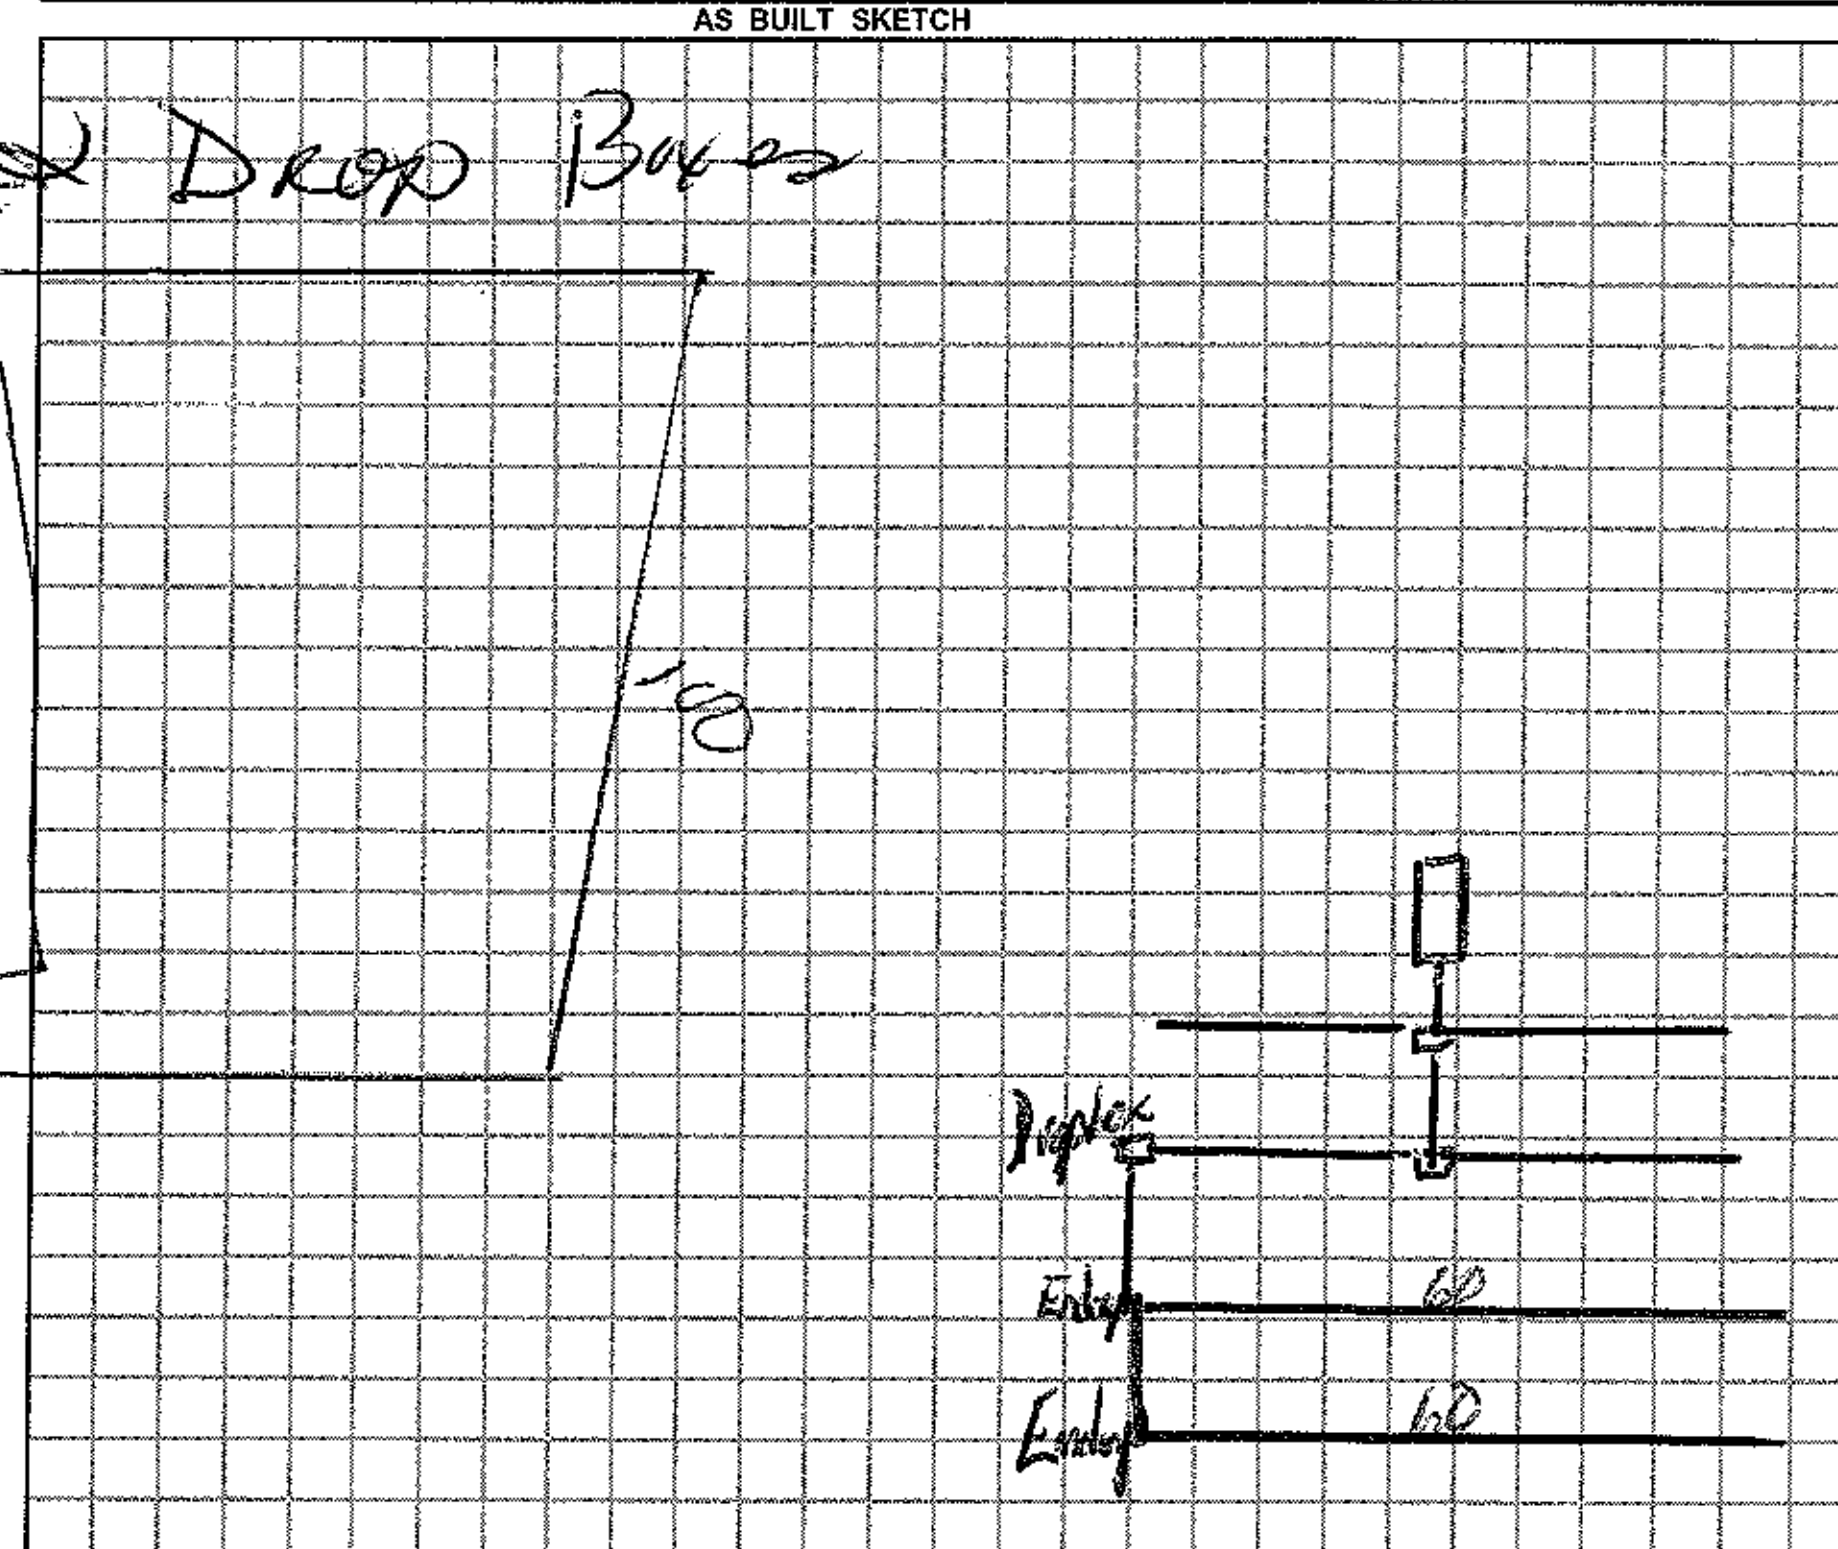

Permit can be suspended or revoked if any false information is supplied toward securing the permit / any unauthorized changes are made to the site / any unauthorized changes are made in the installation of the system.

☐ *IMPROVEMENT PERMIT w / plat valid without expiration.* ☑ *IMPROVEMENT PERMIT w / site plan valid for 60 mos.* ☑ *AUTHORIZATION TO CONSTRUCT valid for period equal to IMPROVEMENT PERMIT-not to exceed 60 mo.*

Owner / Applicant Signature: [signature] Date 7/22/09

Improvement Permit by: [signature] Date 7-24-09

Authorzation to Construct by: [signature] Date 7-24-09

YOU SHOULD CONTACT A LOCATOR SERVICE PRIOR TO ANY EXCAVATION.

Installed by: A-1

Operation Permit by: James Stewart Date: 9-15-09

Existing System Inspected by: Date:

WHITE COPY Environmental Health YELLOW COPY (Final) Owner / Applicant PINK COPY (Initial) Owner / Applicant