IREDELL COUNTY HEALTH DEPARTMENT

STATESVILLE 704-878-5305 MOORESVILLE 704-664-5281

IMPROVEMENT PERMIT / AUTHORIZATION TO CONSTRUCT / OPERATION PERMIT / EXISTING SYSTEM INSPECTION

PERMIT# REPAIR PIN# DATE 7-29-00

OWNER OR CONTRACTOR RUTH GALLIHER PHONE: Business Home 546-2212

ADDRESS 295 KIMMON ROAD, HARMONY, NC 28634

LOCATION US 21 NORTH, TR MT. BETHEL RD, TR ~0.3 MILE, MH AT END ON LEFT

SUBDIVISION BLOCK / SECTION LOT LOT AREA LIMITED SITE CLASS PS DESIGN FLOW 240 L.T.A.R. EXISTING

Septic Tank: EXISTING Gallons: STB Date

Pump Tank: Gallons: PT Date

Pump Make: Model Serial No.

Nitrification Field: No Fields 1 Square Feet 300 Linear Feet 100

No Lines ONE Trench Width 36" Max Trench Bottom Depth ~36" Gravel Depth 24"

☐ New System ☑ Repair System Type: I (II), III, IV, V, VI

System Description: CONV. GRAVITY

Repair System Description: CONV. GRAVITY

Maintenance Agreement Required: ☐ Yes ☑ No

☐ House/Mod. Home ☑ Mobile Home ☐ Business ☐ Other

No. Bedrooms 2 No. Bathrooms 1 No. Employees


☐ Slab ☑ Crawl Space ☐ Basement w/plumbing ☐ Basement wo/plumbing

Water Supply: ☐ Individual ☑ Public ☐ Community

Comments/Conditions: ① KEEP SYSTEM MINIMUM 50 FEET FROM WELL ② INSTALL NEW 3' x 100' LINE AS FLAGGED USING 24" STONE

Comments/Conditions: 138 Mt Bethel

INITIAL SITE SKETCH

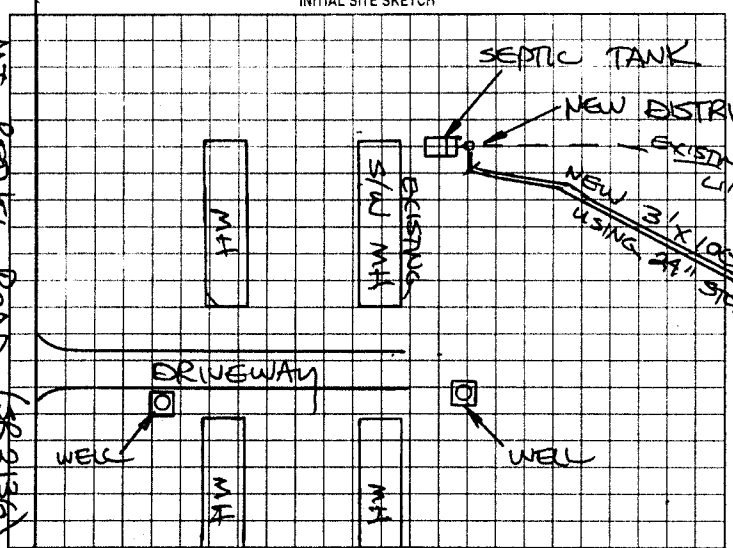

AS BUILT SKETCH

Installed as shown

Permit can be suspended or revoked if any false information is supplied toward securing the permit/any unauthorized changes are made to the site/any unauthorized changes are made in the installation of the system. Improvement Permit with plat valid without expiration. Improvement Permit with site plan valid for sixty months. Authorization to Construct is valid for a period equal to that of Improvement Permit - not to exceed sixty months.

Signed: x Ruth Galliher date 7-29-2000 Installed by: A-1 Backhoe

Improvement Permit by: STEVE HEDRICK date 7-29-00 Operation Permit by: [illegible] date 8-2-00

Authorization to Construct by: STEVE HEDRICK date 7-29-00 Existing System Inspection by: date

HEALTH DEPT COPY WHITE OWNER COPY (FINAL) YELLOW OWNER COPY (INITIAL) PINK