IREDELL COUNTY HEALTH DEPARTMENT

STATESVILLE 704-878-5305 MOORESVILLE 704-664-5281

IMPROVEMENT PERMIT / AUTHORIZATION TO CONSTRUCT / OPERATION PERMIT / EXISTING SYSTEM INSPECTION

PERMIT# 26240 PIN# 4779456114 PT. DATE 2-16-00

OWNER OR CONTRACTOR Greg Safley PHONE: Business Home 546-2084

ADDRESS 210 21N TR Bethel Rd TR Marshal Fm Rd Harmony 28634

LOCATION 21N TR Bethel Rd TR Marshal Fm 1/4 mi TR Long drive at end

SUBDIVISION BLOCK / SECTION LOT LOT AREA 2 acres SITE CLASS. P3 DESIGN FLOW 360 L.T.A.R. .33

Septic Tank: 1000 Gallons; STB 156 Date 8-5-00

Pump Tank: Gallons; PT Date

Pump Make: Model Serial No.

Nitrification Field: No Fields 1 Square Feet 1080 Linear Feet 360

No Lines 4 Trench Width 36" Max Trench Bottom Depth 36" Gravel Depth 12"

☑ New System ☐ Repair System Type: I. II. III. IV. V. VI.

System Description: conv. Gravity

Repair System Description:

Maintenance Agreement Required: ☐ Yes ☑ No

☐ House/Mod. Home No. Bedrooms 3

☑ Mobile Home No. Bathrooms 2

☐ Business No. Employees

☐ Other


☐ Slab ☑ Crawl Space ☐ Basement w/plumbing ☐ Basement wo/plumbing

Water Supply: ☑ Individual ☐ Public ☐ Community


Comments/Conditions:

Comments/Conditions: SEPTIC TANK WITH MARKER INSTALLED USING "ZABEL" FILTER

INITIAL SITE SKETCH

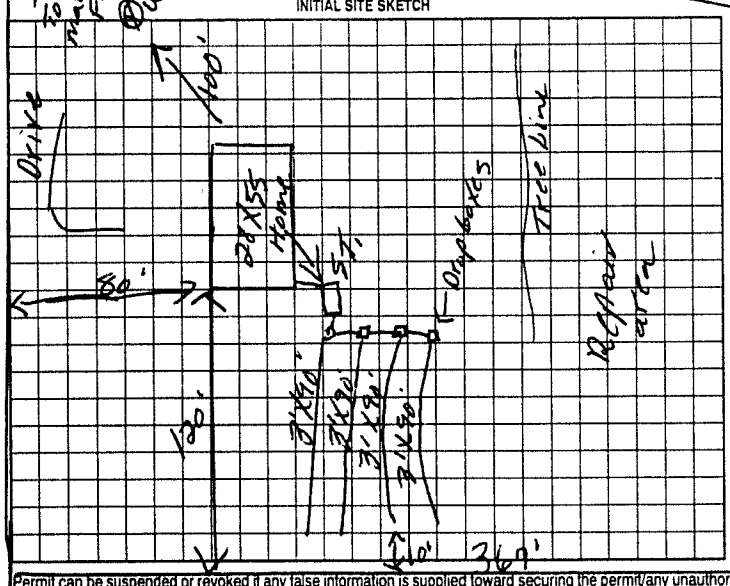

AS BUILT SKETCH

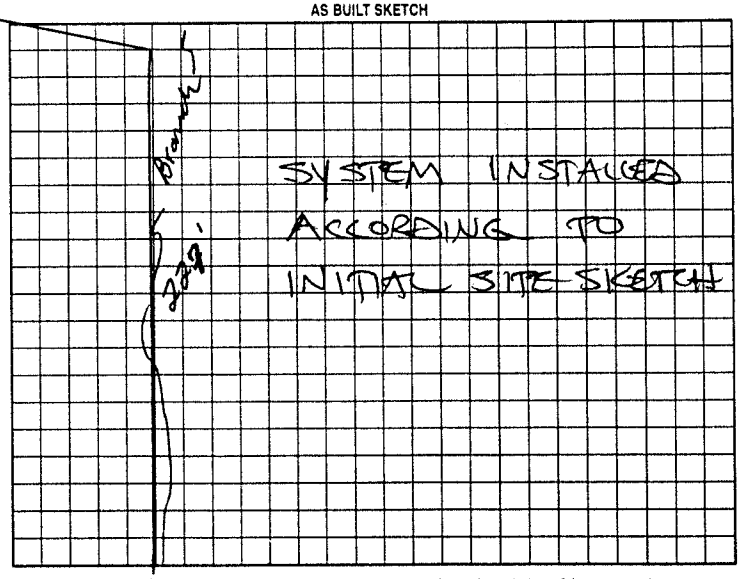

Permit can be suspended or revoked if any false information is supplied toward securing the permit/any unauthorized changes are made to the site/any unauthorized changes are made in the installation of the system. Improvement Permit with plat valid without expiration. Improvement Permit with site plan valid for sixty months. Authorization to Construct is valid for a period equal to that of Improvement Permit - not to exceed sixty months.

Signed: X Jay Safley date 2-16-00 Installed by: BRENT GALLIHER

Improvement Permit by: P. C. Moore date 2-16-00 Operation Permit by: STEVE HENDRICK date 10-10-00

Authorization to Construct by: P. C. Moore date 2-16-00 Existing System Inspection by: date

HEALTH DEPT. COPY: WHITE OWNER COPY (FINAL): YELLOW OWNER COPY (INITIAL): PINK