IREDELL COUNTY HEALTH DEPARTMENT

STATESVILLE 704-878-5305 (a) MOORESVILLE 704-664-5281

IMPROVEMENT PERMIT / AUTHORIZATION TO CONSTRUCT / OPERATION PERMIT / EXISTING SYSTEM INSPECTION

PERMIT # 158327 PIN # 4779485039 DATE 10-6-09

OWNER or APPLICANT John Osborne PHONE: Business Home: 704-546-2179

OWNER or APPLICANT ADDRESS 187 Mt Bethel RD Harmony NC 28634

LOCATION / DIRECTIONS 21N (TR) Mt Bethel RD at corner of Brianna

SUBDIVISION BLOCK / SECTION LOT # 56 LOT AREA .92 DESIGN FLOW 240 L.T.A.R. .25

Septic Tank 1000 Gallons: STB 760 Date 5-24-09
Pump Tank Gallons: P T Date
Pump Make Model Serial #
Nitrification Field No Fields No Lines 4 Linear Feet 240
Trench Width 36" Max. Trench Bottom Depth 30" Gravel Depth

☑ New System ☐ Repair ☐ Expansion System Type I II III IV V VI
System Description: 25% Graywater
Repair System Description: 25% Graywater 4 pump
Maintenance Agreement Required ☐ YES ☐ NO
☑ GRAVITY ☐ PRESSURE


☑ Residence No. Bedrooms 2
☐ Business No. Persons
☐ Other No. Employees
☐ Slab ☐ Crawl Space
☐ Basement w/plumbing ☐ Basement w/o plumbing

Water Supply: ☐ Private ☑ Public ☐ Community

Comments / Conditions

200 PL

INITIAL SITE SKETCH

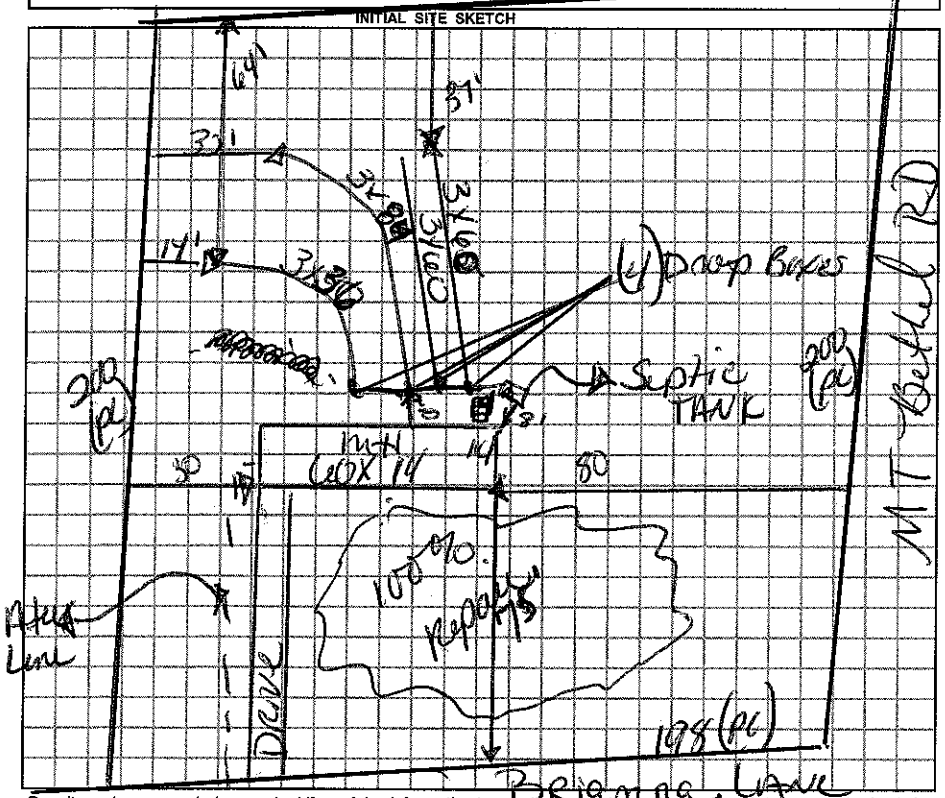


Comments / Conditions

Install on contour
Maintain all setback

AS BUILT SKETCH

30" Trench Bottom.
Before Repair installation must remove Farm Terrace

Red Surface Fills Septic Mound

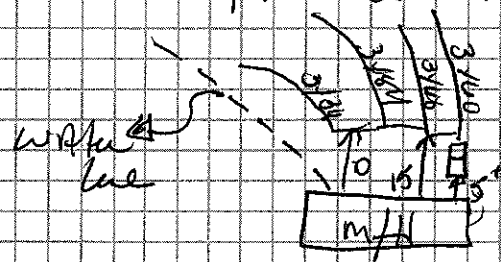

Permit can be suspended or revoked if any false information is supplied towards securing the permit / any unauthorized changes are made to the site / any unauthorized changes are made in the installation of the system.

☐ *IMPROVEMENT PERMIT w / plat valid without expiration.* ☑ *IMPROVEMENT PERMIT w / site plan valid for 60 mos.* ☑ *AUTHORIZATION TO CONSTRUCT valid for period equal to IMPROVEMENT PERMIT-not to exceed 60 mo.*

Owner / Applicant Signature: John Osborne Date 10-13-09

Improvement Permit by: Kelly Cook Date 10-6-09

Authorzation to Construct by: Kelly Cook Date 10-6-09

YOU SHOULD CONTACT A LOCATOR SERVICE PRIOR TO ANY EXCAVATION.

Installed by: A-Z Backhoe

Operation Permit by: Kelly Cook Date: 10-29-09

Existing System Inspected by: Date:

WHITE COPY Environmental Health YELLOW COPY (Final) Owner / Applicant PINK COPY (Initial) Owner / Applicant