IREDELL COUNTY HEALTH DEPARTMENT

STATESVILLE 704-878-5305 MOORESVILLE 704-664-5281

(21)

IMPROVEMENT PERMIT / AUTHORIZATION TO CONSTRUCT / OPERATION PERMIT / EXISTING SYSTEM INSPECTION

PERMIT# 128232 PIN# 4779-48-6617 DATE 5-20-05

OWNER OR CONTRACTOR FLEETWOOD HOMES OF STATESVILLE PHONE: Business 704-872-0179 Home

ADDRESS 1270 NORTHSIDE DRIVE, STATESVILLE, NC 28677

LOCATION US 21 NORTH, TR MT. BETHEL ROAD, TL BRIANNA LANE, MH STRAIGHT AHEAD AT END

SUBDIVISION BLOCK / SECTION LOT LOT AREA 2.00 ACRES SITE CLASS. PS DESIGN FLOW 360 L.T.A.R. EXISTING

Septic Tank: 1000 Gallons; STB Date

Pump Tank: Gallons; PT Date

Pump Make: Model Serial No.

Nitrification Field: No Fields 1 Square Feet Linear Feet EXISTING

No Lines Trench Width Max Trench Bottom Depth Gravel Depth

☐ New System ☐ Repair System Type: I, II, III, IV, V, VI

System Description: CONVENTIONAL, GRAVITY

Repair System Description:

Maintenance Agreement Required: ☐ Yes ☒ No

☐ Slab ☐ Crawl Space ☐ Basement w/plumbing ☐ Basement wo/plumbing

☐ House/Mod. Home No. Bedrooms 3

☑ Mobile Home No. Bathrooms

☐ Business No. Employees


☐ Other

Water Supply:
☐ Individual
☑ Public
☐ Community


Comments:/Conditions:

Comments:/Conditions:

INITIAL SITE SKETCH

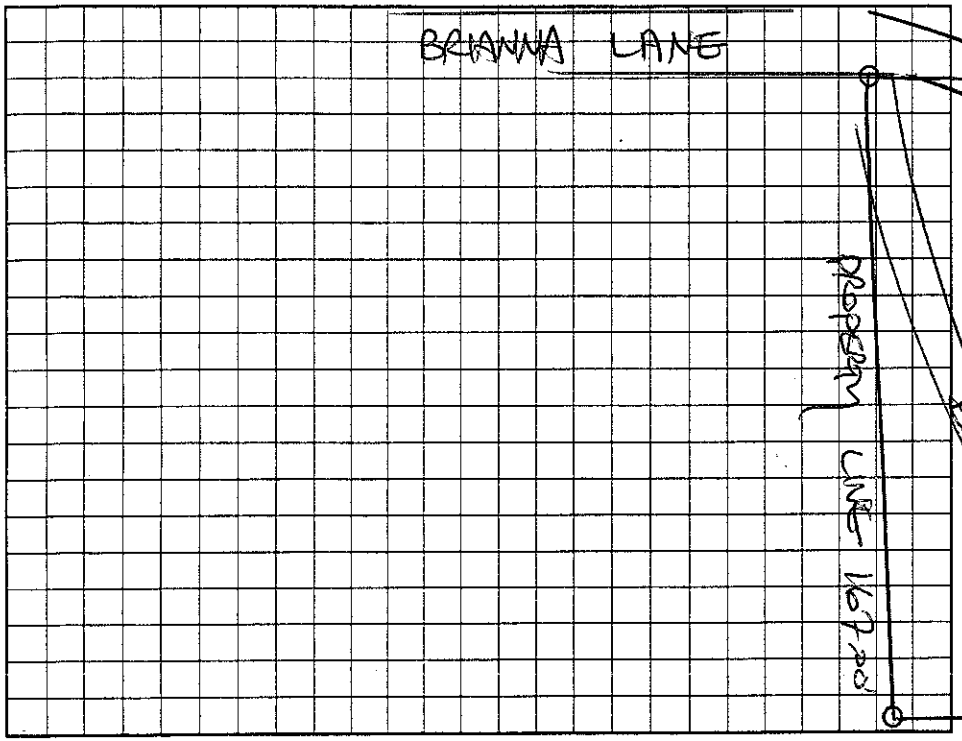

AS BUILT SKETCH

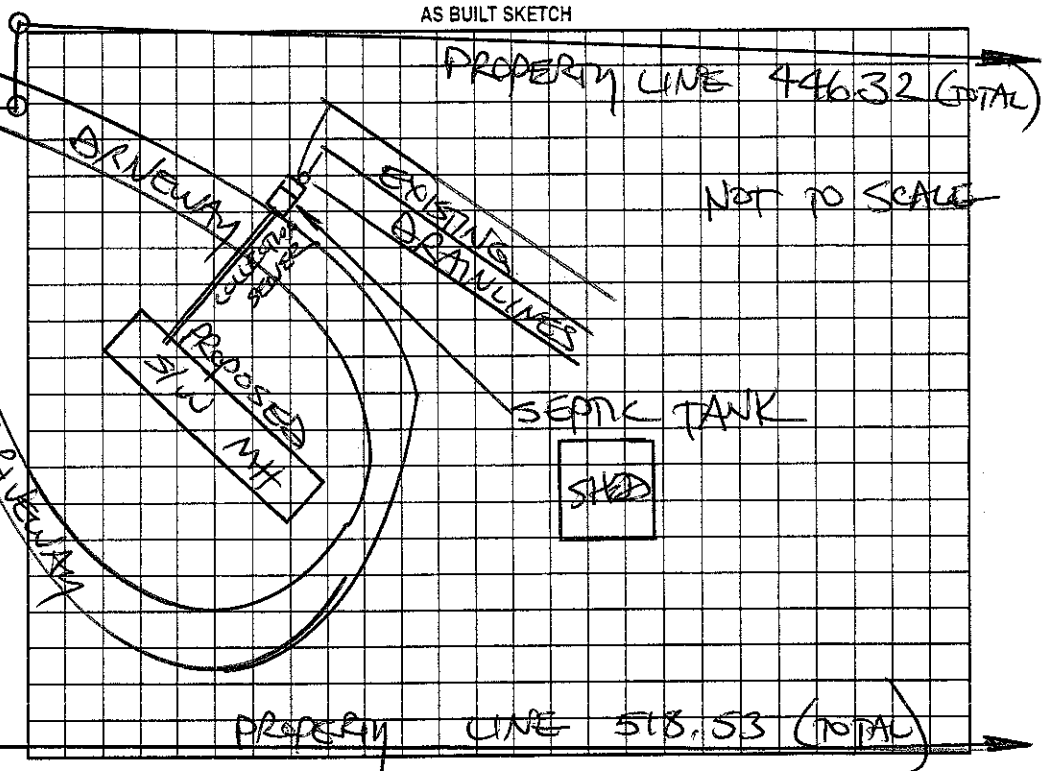

Permit can be suspended or revoked if any false information is supplied toward securing the permit/any unauthorized changes are made to the site/any unauthorized changes are made in the installation of the system. Improvement Permit with plat valid without expiration. Improvement Permit with site plan valid for sixty months. Authorization to Construct is valid for a period equal to that of Improvement Permit – not to exceed sixty months.

Signed: date

Improvement Permit by: date

Authorization to Construct by: date

Installed by:

Operation Permit by: date

Existing System Inspection by: STEVE HEDRICK date 5-20-05

HEALTH DEPT. COPY: WHITE OWNER COPY (FINAL): YELLOW OWNER COPY (INITIAL): PINK