IREDELL COUNTY HEALTH DEPARTMENT

STATESVILLE 704-878-5305 (C1) MOORESVILLE 704-664-5281

IMPROVEMENT PERMIT / CERTIFICATE OF COMPLETION / OPERATION PERMIT / EXISTING SYSTEM INSPECTION

PROPERTY DESCRIPTION NO. 070009 DATE 11-6-97 TAX MAP NO. 4779 49 0895 Watershed: ☐ Yes ☑ No

OWNER OR CONTRACTOR DAVID PERRY PHONE: Business Home 838-6907

ADDRESS 332 YORK SPANN RD, HAMPTONVILLE, NC 27020

LOCATION US 21 N, TR GLENWOOD VALLEY DRIVE 3RD, LOT ON RIGHT

SUBDIVISION GLENWOOD BLOCK / SECTION LOT 29 LOT AREA 100'X200' SITE CLASS. PS DESIGN FLOW 360 L.T.A.R. 0.35 GAD/FT²

Septic Tank: 1000 Gallons; STB 1012 Date 9-29-01

Pump Tank: Gallons; PT Date

Pump Make: Model Serial No.

Nitrification Field: No Fields 1 Square Feet 1035 Linear Feet 345

No Lines FIVE Trench Width 36" Max Trench Bottom Depth 36" Gravel Depth 12"

☑ New System ☐ Repair System Type: I, II, III, IV, V, VI

System Description: CONVENTIONAL GRAVITY

Repair System Description: CONV. GRAV/PUMP

Maintenance Agreement Required: ☐ Yes ☑ No

☑ House/Mod. Home No. Bedrooms 3

☐ Mobile Home No. Bathrooms 2

☐ Business No. Employees

☐ Other


☐ Slab ☑ Crawl Space ☐ Basement w/plumbing ☐ Basement wo/plumbing

Water Supply: ☐ Individual ☐ Community ☑ Public


Comments: REMOVE EXISTING FIELD TERRACE

Comments: SEPTIC TANK WITH MARKER INSTALLED USING "POLY LOK" FILTER

INITIAL SITE SKETCH SCALE: 1"=40'

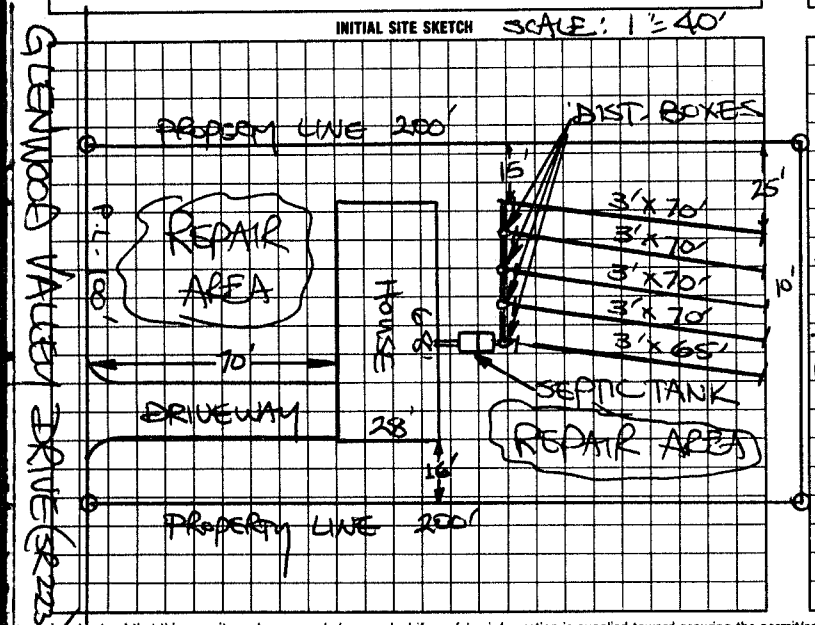

AS BUILT SKETCH

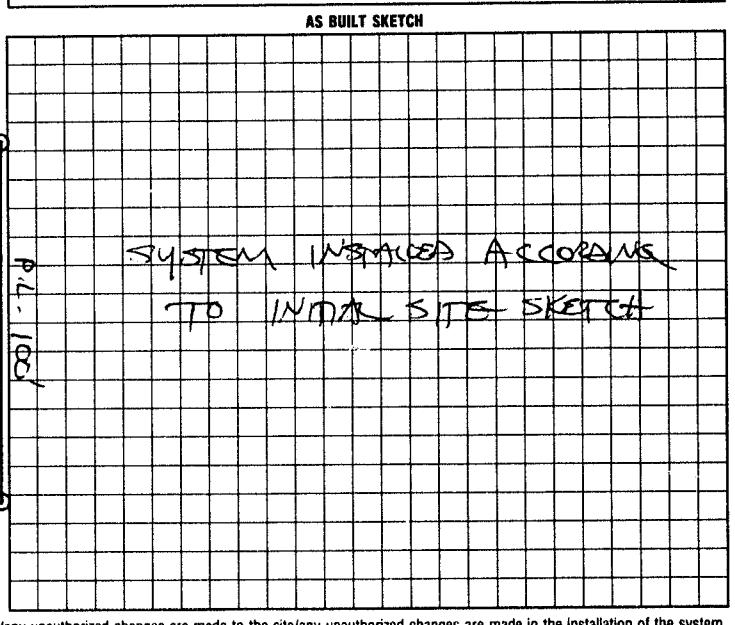

I understand that this permit can be suspended or revoked if any false information is supplied toward securing the permit/any unauthorized changes are made to the site/any unauthorized changes are made in the installation of the system. Improvement Permit is valid for 60 months from date of issuance. AUTHORIZATION TO CONSTRUCT IS VALID FOR 60 MONTHS FROM DATE OF ISSUANCE.

Signed: David M. Perry

Improvement Permit by: STEVE HEDRICK date 11-6-97

AUTH. TO CONST. ~~Existing System Inspection~~ by: STEVE HEDRICK date 11-6-97

Installed by: TOMMY FRYE

~~Certificate of Completion by:~~ date

Operation Permit by: STEVE HEDRICK date 1-28-02

HEALTH DEPT. COPY: WHITE INSPECTION COPY (FINAL): GREEN OWNER COPY (FINAL): YELLOW INSPECTION COPY (INITIAL): PINK OWNER COPY (INITIAL): GOLD