IREDELL COUNTY HEALTH DEPARTMENT

STATESVILLE 704-878-5305 MOORESVILLE 704-664-5281

IMPROVEMENT PERMIT / AUTHORIZATION TO CONSTRUCT / OPERATION PERMIT / EXISTING SYSTEM INSPECTION

PERMIT# 146289 PIN# 4779496821 DATE 3-14-07

OWNER OR APPLICANT Wesley Community Develop. Corp. PHONE: Business 704-924-8942 Home

ADDRESS 321 S. Dixie Drive, Statesville NC 28634

LOCATION 21N Glenwood Valley Off Eaton Road

SUBDIVISION Glenwood Valley BLOCK / SECTION ○ LOT 24 LOT AREA .447 SITE CLASS. DESIGN FLOW 360 L.T.A.R. .25

Septic Tank: 1000 Gallons; STB 1000 Date 1-2-07
Pump Tank: Gallons; PT Date
Pump Make: Model Serial No.
Nitrification Field: No Fields Square Feet 1440 Linear Feet 360
No Lines 6 Trench Width 36" Max Trench Bottom Depth 36"

☑ New System ☐ Repair ☐ Expansion System Type: I II (III) IV V VI
System Description: 25% Gravity
Repair System Description: Low pres. panel
Maintenance Agreement Required: ☐ Yes ☑ No
Gravel Depth ☐ Gravity ☐ Pressure

☑ House/Mod. Home ☐ Mobile Home ☐ Business ☐ Other
No. Bedrooms 3 No. Persons No. Employees


Water Supply: ☐ Individual ☑ Public ☐ Community

☐ Slab ☑ Crawl Space ☐ Basement w/plumbing ☐ Basement wo/plumbing

Comments:/Conditions:
Use end cap distribution
Install on Contour
Maintain all setbacks

Comments:/Conditions:
Plumbing Stub out must be high to achieve gravity

INITIAL SITE SKETCH

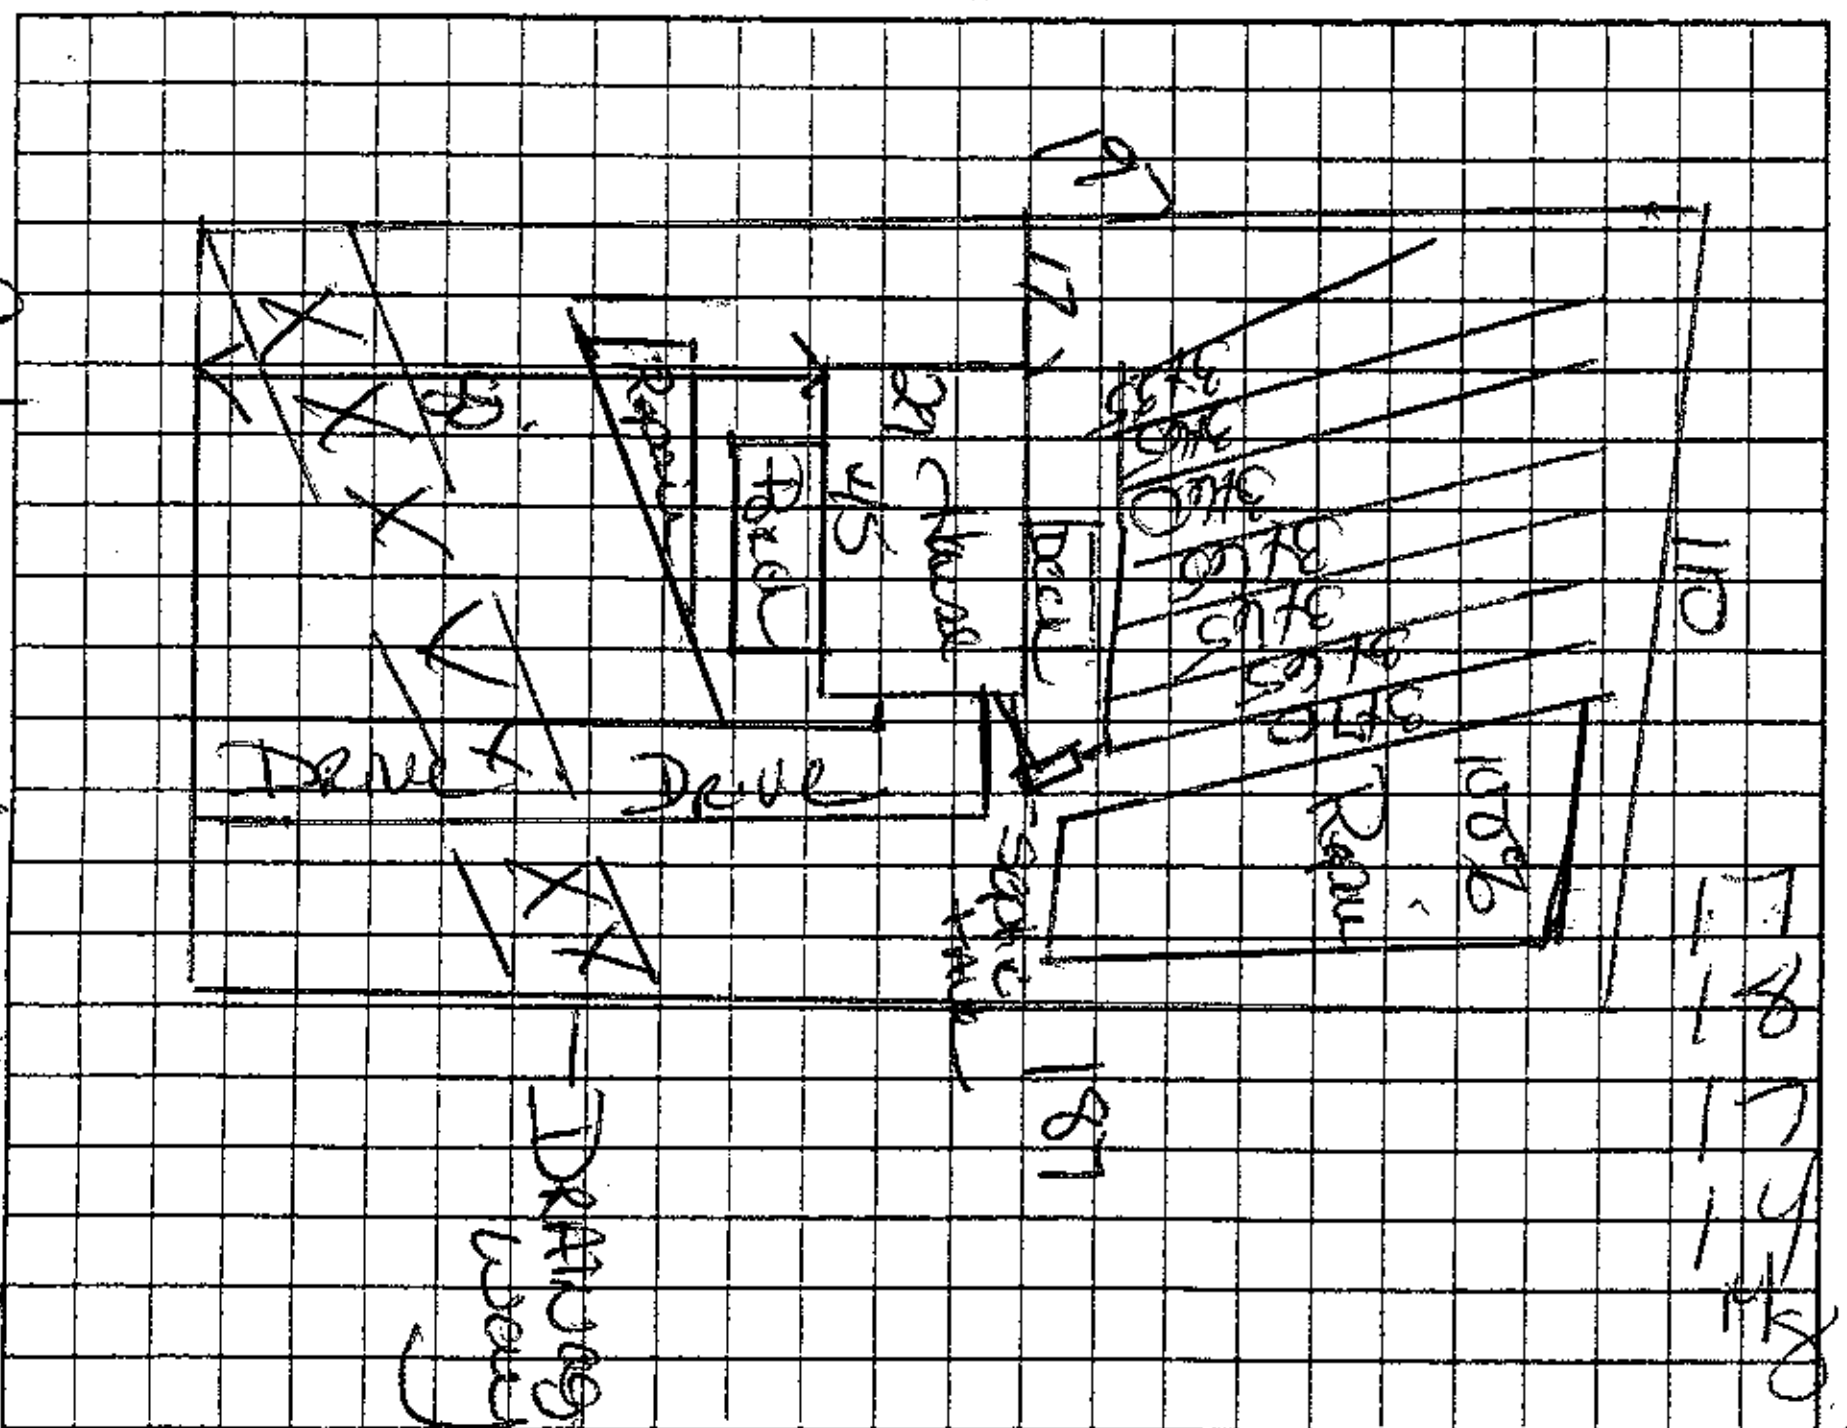

Glenwood Valley Drive

AS BUILT SKETCH

* Back Deck Must have piers back 5 feet from edge — edge at end of Septic lines.

* Screen Side walls

Orange Perc 100 Filter
Septic tank Marked

Chambers

Permit can be suspended or revoked if any false information is supplied toward securing the permit/any unauthorized changes are made to the site/any unauthorized changes are made in the installation of the system. Improvement Permit with plat valid without expiration ☐ Improvement Permit with site plan valid for sixty months ☐ Authorization to Construct is valid for a period equal to that of Improvement Permit – not to exceed sixty months.

Signed: Tommy Cohren date

Improvement Permit by: Kelly Cook date 3-14-07

Authorization to Construct by: Kelly Cook date 3-14-07

Installed by: Tommy Cohren

Operation Permit by: Kelly Cook date 3-14-07

Existing System Inspection by: date

HEALTH DEPT. COPY: WHITE OWNER COPY (FINAL): YELLOW OWNER COPY (INITIAL): PINK