IREDELL COUNTY HEALTH DEPARTMENT

STATESVILLE 704-878-5305 MOORESVILLE 704-664-5281

IMPROVEMENT PERMIT / AUTHORIZATION TO CONSTRUCT / OPERATION PERMIT / EXISTING SYSTEM INSPECTION

PERMIT# 1-10-08 PIN# 4779499822 DATE 1-25-07

OWNER OR APPLICANT DAVID Perry PHONE: Business 704-838-6907 Home

ADDRESS 322 York Sparrow RD Hamptonville NC 27020

LOCATION 21N to Glenwood Valley Dr 1/4 mile on Right

SUBDIVISION Glenwood BLOCK / SECTION LOT 23 LOT AREA .978 SITE CLASS. RS DESIGN FLOW 360 L.T.A.R. .3

Septic Tank: 1000 Gallons: STB 702 Date 1-29-07

Pump Tank: Gallons: PT Date

Pump Make: Model Serial No.

Nitrification Field: No Fields Square Feet 1200 Linear Feet 300

No Lines 4 Trench Width 36" Max Trench Bottom Depth 36" Gravel Depth ☐ Gravity ☐ Pressure

☑ New System ☐ Repair ☐ Expansion System Type: I II IV V VI

System Description: 25% Graywater

Repair System Description: 50% Increase

Maintenance Agreement Required: ☐ Yes ☐ No

☐ House/Mod. Home No. Bedrooms 3

☐ Mobile Home No. Persons

☐ Business No. Employees

☐ Other


Water Supply: ☐ Individual ☐ Public ☐ Community

☐ Slab ☑ Crawl Space ☐ Basement w/plumbing ☐ Basement wo/plumbing


Comments:/Conditions: Install as Capture Maintain all setbacks

Comments:/Conditions: Yellow Surface Tabs

INITIAL SITE SKETCH

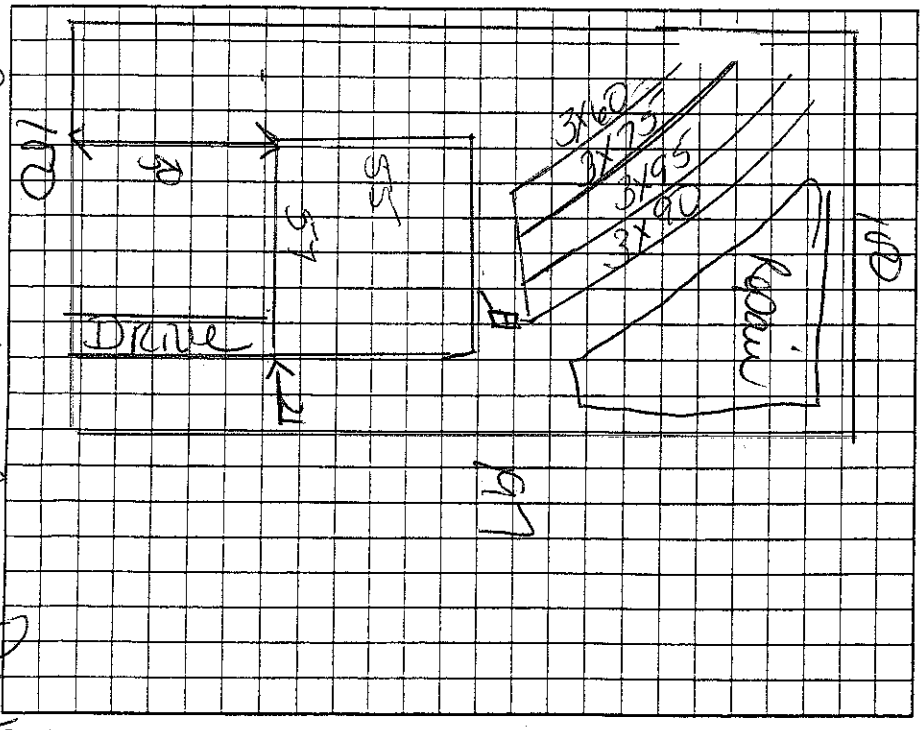

AS BUILT SKETCH

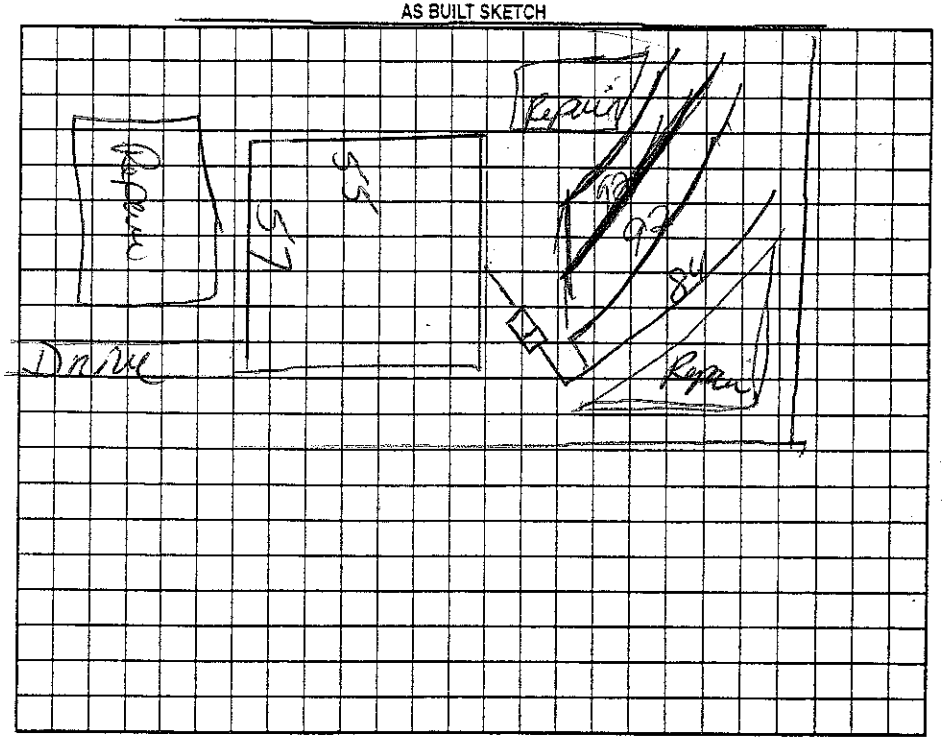

Permit can be suspended or revoked if any false information is supplied toward securing the permit/any unauthorized changes are made to the site/any unauthorized changes are made in the installation of the system. Improvement Permit with plat valid without expiration ☐ Improvement Permit with site plan valid for sixty months ☐ Authorization to Construct is valid for a period equal to that of Improvement Permit – not to exceed sixty months.

Signed: David M. Perry date 1-26-07 Installed by: Tommy Frye

Improvement Permit by: Keith Cook date 1-25-07 Operation Permit by: Keith Cook date 8-30-07

Authorization to Construct by: Keith Cook date 1-25-07 Existing System Inspection by: date

HEALTH DEPT. COPY: WHITE OWNER COPY (FINAL): YELLOW OWNER COPY (INITIAL): PINK