IREDELL COUNTY HEALTH DEPARTMENT - *ENVIRONMENTAL HEALTH* ☑ STATESVILLE OFFICE 704-878-5305 ☐ MOORESVILLE OFFICE 704-664-5281

IMPROVEMENT PERMIT / AUTHORIZATION TO CONSTRUCT / OPERATION PERMIT / EXISTING SYSTEM INSPECTION

PERMIT # 163681 PIN # 4779-55-5829 DATE 4 November 10

OWNER Robert Swaim APPLICANT: PHONE: Home/Cell # (704) 873-2547 Business #

SITE ADDRESS 151 Marshall Farm rd. Harmony OWNER / APPLICANT ADDRESS

SITE DIRECTIONS Hwy 21 N TR Bethel Ch. TR Marshall Farm Rd. Lot on Lt. Fl.

SUBDIVISION BLOCK / SECTION LOT # LOT AREA 1.25Ac- DESIGN FLOW 240 gpd L.T.A.R. 0.3 gpd/ft²

Septic Tank Exist. Gallons: STB Date

Pump Tank Gallons: P T Date

Pump Make Model Serial #

No. Nitrification Fields: Exist No. Lines Linear Feet Exist.

Trench Width Max. Trench Bottom Depth Gravel Depth

☐ New System ☐ Repair ☐ Expansion System Type I (II) III IV V VI

System Description: Gravel Trench

Repair System Description:

Maintenance Agreement Required ☐ YES ☑ NO

☑ GRAVITY ☐ PRESSURE

☑ Residence No. Bedrooms 2

☐ Business No. Persons

☐ Other No. Employees

☐ Slab ☑ Crawl Space

☐ Basement w/plumbing ☐ Basement w/o plumbing

Water Supply

☑ Private


☐ Public

☐ Community

Comments / Conditions

INITIAL SITE SKETCH

AS BUILT SKETCH

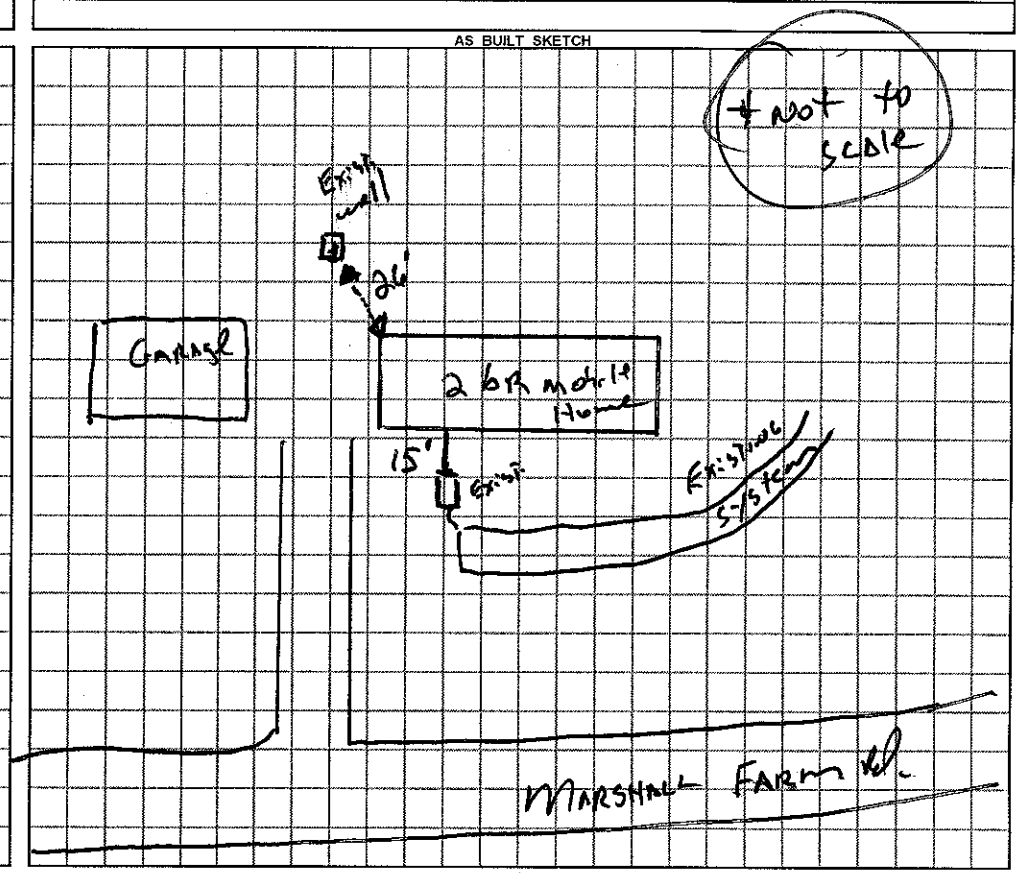

Permit can be suspended or revoked if any false information is supplied toward securing the permit / any unauthorized changes are made to the site / any unauthorized changes are made in the installation of the system.

☐ ***IMPROVEMENT PERMIT*** with plat valid without expiration. ☐ ***IMPROVEMENT PERMIT*** with plat valid without expiration. ☐ ***AUTHORIZATION TO CONSTRUCT*** valid for period equal to IMPROVEMENT PERMIT--not to exceed 60 mo.

Owner / Applicant Signature: Date 11/5/10 Installed by:

IMPROVEMENT PERMIT by: REHS Date OPERATION PERMIT by: REHS Date

AUTHORIZATION TO CONSTRUCT by: REHS Date Existing System Inspected by: , R.S REHS Date 4 Nov. 10

YOU SHOULD CONTACT A LOCATOR SERVICE PRIOR TO ANY EXCAVATION

White Copy – Environmental Health YELLOW COPY (Final) Owner / Applicant PINK COPY (Initial) Owner / Applicant