IREDELL COUNTY HEALTH DEPARTMENT

STATESVILLE 704-878-5305 MOORESVILLE 704-664-5281

IMPROVEMENT PERMIT / AUTHORIZATION TO CONSTRUCT / OPERATION PERMIT / EXISTING SYSTEM INSPECTION

PERMIT# 107051 PIN# ~~4779-68-5129-1~~ ~~4779-58-3706~~ 4779574907 DATE 7-1-02

OWNER OR CONTRACTOR FILBERT W. PISHNER PHONE: Business Home 704-546-7478

ADDRESS 120 PISHNER DRIVE HARMONY, NC 28634

LOCATION US 21 N, TR BETHEL ROAD TL PISHNER DRIVE, 1ST LOT ON RIGHT PAST ESTHER DR.

SUBDIVISION PISHNER ESTATES BLOCK / SECTION 4 LOT 17 LOT AREA 0.824 AC SITE CLASS. PS DESIGN FLOW 360 L.T.A.R. 0.30 GPD/FT²

Septic Tank: 1000 Gallons; STB 700 Date 6-5-07

Pump Tank: ____ Gallons; PT ____ Date ____

Pump Make: ____ Model ____ Serial No. ____

Nitrification Field: No Fields 1 Square Feet EQ. TO 1200 Linear Feet 200

No Lines FOUR Trench Width 24" Max Trench Bottom Depth 36" ~~Gravel~~ Depth ~~SAND~~ 6"

☑ New System ☐ Repair System Type: I, II, III, IV, V, VI

System Description: 50% REDUCTION GRAVITY

Repair System Description: 50% REDUCTION, PUMP

Maintenance Agreement Required: ☐ Yes ☑ No

☐ House/Mod. Home ☑ Mobile Home ☐ Business ☐ Other

No. Bedrooms 3 No. Bathrooms 2 No. Employees ____

☐ Slab ☐ Crawl Space ☑ Basement w/plumbing ☑ Basement wo/plumbing


Water Supply: ☐ Individual ☑ ~~Public~~ ☐ Community

Comments/Conditions: INSTALL 50% REDUCTION SYSTEM USING 44 PPBPS PANELS IN FOUR EQUAL LENGTH LINES ON CONTOUR AS FLAGGED


Comments/Conditions: Red filter

SCALE: 1" = 50'

INITIAL SITE SKETCH

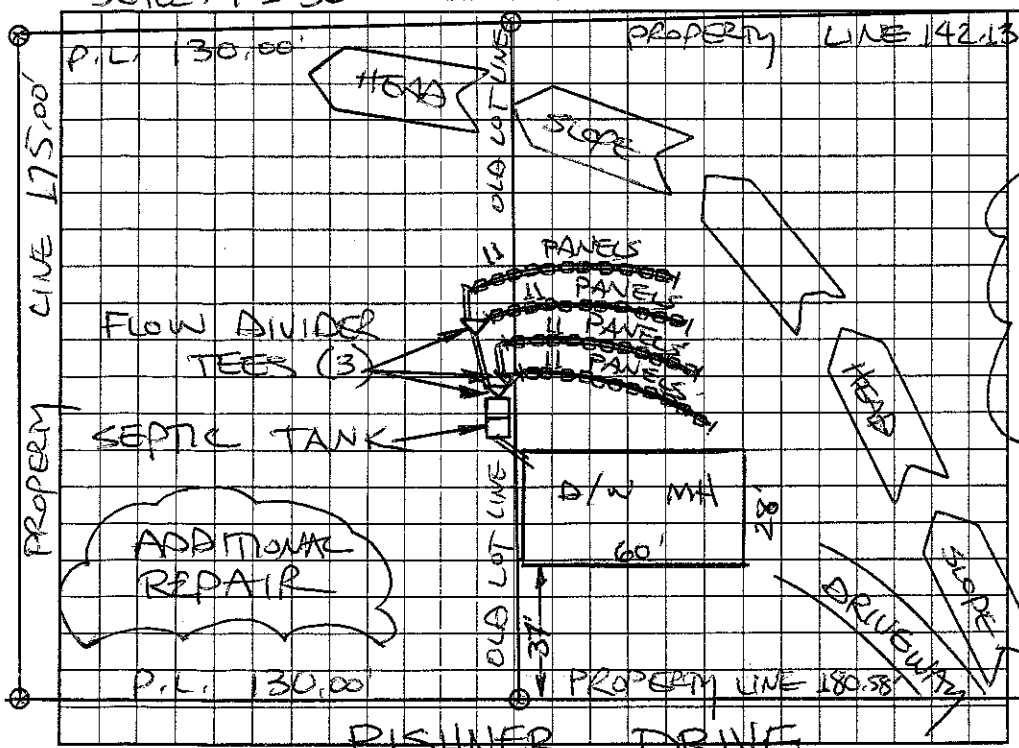

AS BUILT SKETCH

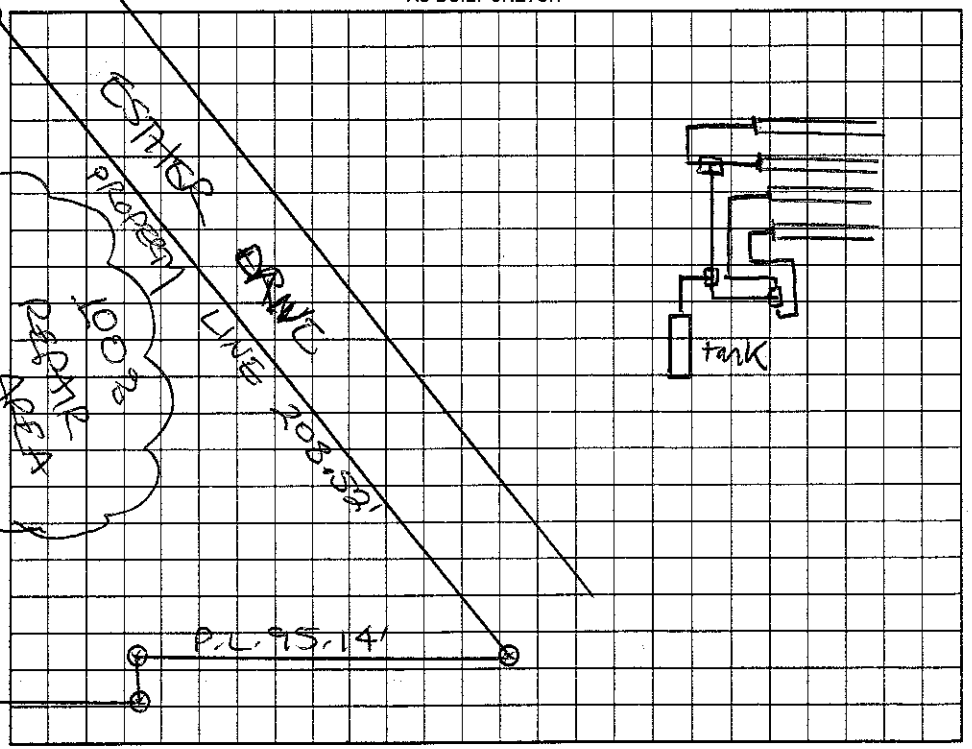

Permit can be suspended or revoked if any false information is supplied toward securing the permit/any unauthorized changes are made to the site/any unauthorized changes are made in the installation of the system. Improvement Permit with plat valid without expiration, Improvement Permit with site plan valid for sixty months. Authorization to Construct is valid for a period equal to that of Improvement Permit – not to exceed sixty months.

Signed: Fil Pishner date ____ Installed by: Sonny Ramos

Improvement Permit by: STEVE HEDRICK date 7-1-02 Operation Permit by: [signature] date 2-9-07

Authorization to Construct by: STEVE HEDRICK date 7-1-02 Existing System Inspection by: ____ date ____

HEALTH DEPT. COPY: WHITE OWNER COPY (FINAL): YELLOW OWNER COPY (INITIAL): PINK