IREDELL COUNTY HEALTH DEPARTMENT

STATESVILLE 704-878-5305 MOORESVILLE 704-664-5281

IMPROVEMENT PERMIT / AUTHORIZATION TO CONSTRUCT / OPERATION PERMIT / EXISTING SYSTEM INSPECTION

PERMIT# 107052 PIN# ~~4779-68-5129-4~~ 4779-58-3106 DATE 6-27-02

OWNER OR CONTRACTOR FILBERT W. PISHNER PHONE: Business _____ Home 704-546-7478

ADDRESS 127 PISHNER DRIVE HARMONY, NC 28634

LOCATION US 21 N TR MT. BETHEL RD, TL PISHNER DR, 3RD LOT ON LEFT

SUBDIVISION PISHNER ESTATES BLOCK / SECTION I LOT 4 LOT AREA 0.465 ACRE SITE CLASS PS DESIGN FLOW 360 L.T.A.R. 0.30 GPD/FT²

Septic Tank: 1000 Gallons; STB SEW Date 8-27-99

Pump Tank: _____ Gallons; PT _____ Date _____

Pump Make: _____ Model _____ Serial No. _____

Nitrification Field: No Fields 1 Square Feet ~~60 to 1200~~ Linear Feet 200+

No Lines SIX Trench Width 24" Max Trench Bottom Depth 36" ~~Gravel~~ Depth SAND 6"

☒ New System ☐ Repair System Type: I, II, (III), IV, V, VI

System Description: 50% REDUCTION, GRAVITY

Repair System Description: 50% REDUCTION, LOW-PRESSURE

Maintenance Agreement Required: ☐ Yes ☒ ~~No~~

☐ House/Mod. Home No. Bedrooms 3

☒ Mobile Home No. Bathrooms 2

☐ Business No. Employees _____

☐ Other _____


☐ Slab ☒ ~~Crawl Space~~ ☐ Basement w/plumbing ☐ Basement wo/plumbing

Water Supply: ☒ Individual ☒ Public ☐ Community

Comments:/Conditions: INSTALL 50% REDUCTION SYSTEM USING 48 PPBPS PANELS IN SIX EQUAL LENGTH LINES ON CONTOUR AS FLAGGED.

Comments:/Conditions:

INITIAL SITE SKETCH SCALE: 1"=40'

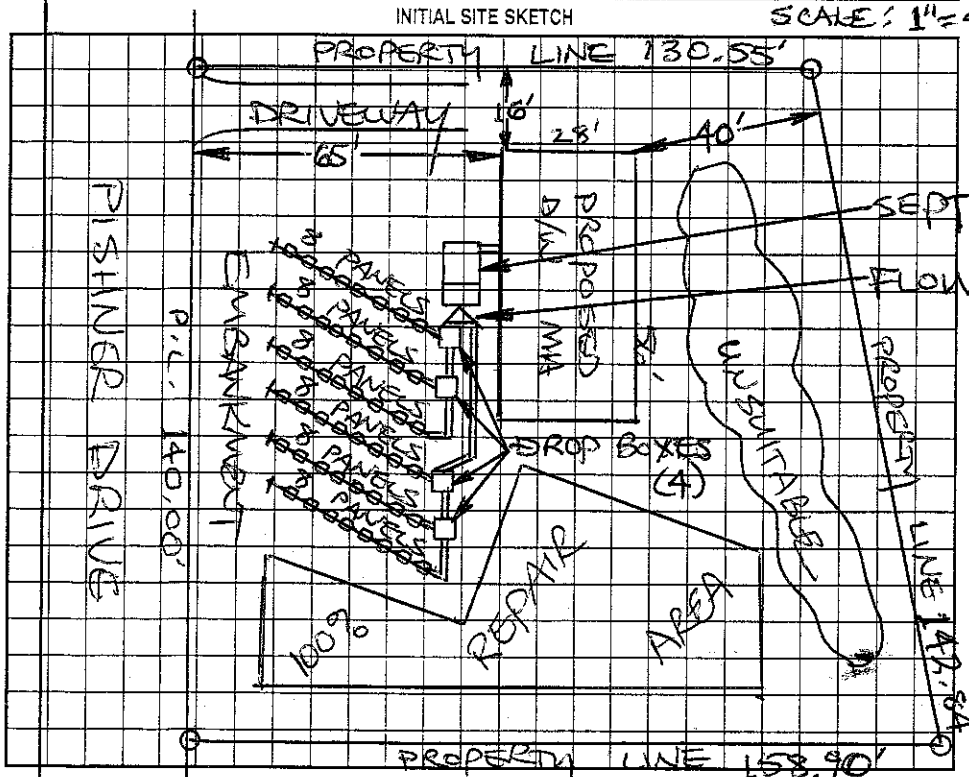

AS BUILT SKETCH

House NOT installed

Red poly lock

Septic tank inlet

Permit can be suspended or revoked if any false information is supplied toward securing the permit/any unauthorized changes are made to the site/any unauthorized changes are made in the installation of the system. Improvement Permit with plat valid without expiration. Improvement Permit with site plan valid for sixty months. Authorization to Construct is valid for a period equal to that of Improvement Permit – not to exceed sixty months.

Signed: Fil Pishner date 7-3-02 Installed by: SAMMY REWIS

Improvement Permit by: STEVE HEDRICK date 6-27-02 Operation Permit by: Kelly Cook date 2-28-07

Authorization to Construct by: STEVE HEDRICK date 6-27-02 Existing System Inspection by: _____ date _____

HEALTH DEPT. COPY: WHITE OWNER COPY (FINAL): YELLOW OWNER COPY (INITIAL): PINK