IREDELL COUNTY HEALTH DEPARTMENT

STATESVILLE 704-878-5305 MOORESVILLE 704-664-5281

IMPROVEMENT PERMIT / AUTHORIZATION TO CONSTRUCT / OPERATION PERMIT / EXISTING SYSTEM INSPECTION

PERMIT# 107053 PIN# ~~4779-68-5129.5~~ 4779-58-3167 DATE 6-28-02

OWNER OR CONTRACTOR FILBERT W. PISHNER PHONE: Business Home 704-546-7478

ADDRESS 141 PISHNER DRIVE, HARMONY NC 28634

LOCATION US 21 N, TR BETHEL ROAD, TL PISHNER DRIVE, 4TH LOT ON LEFT

SUBDIVISION PISHNER ESTATES BLOCK / SECTION I LOT 5 LOT AREA 0.463 ACRE SITE CLASS PS DESIGN FLOW 360 L.T.A.R. 0.30 GPD/FT²

Septic Tank: 1000 Gallons; STB ~~750~~ Date 9-4-04

Pump Tank: _____ Gallons; PT _____ Date _____

Pump Make: _____ Model _____ Serial No. _____

Nitrification Field: No Fields 1 Square Feet EQ.TO 1200 Linear Feet 200+

No Lines SIX Trench Width 24" Max Trench Bottom Depth 36" ~~Gravel Depth~~ SAND 6"

☐ ~~New~~ System ☐ Repair System Type: I, II, (III), IV, V, VI

System Description: 50% REDUCTION, GRAVITY

Repair System Description: 50% REDUCTION, Pump

Maintenance Agreement Required: ☐ Yes ☑ ~~No~~

☐ House/Mod. Home ☑ ~~Mobile Home~~ ☐ Business ☐ Other

No. Bedrooms 3 No. Bathrooms 2 No. Employees ____


Water Supply: ☐ Individual ☑ ~~Public~~ ☐ Community

☐ Slab ☑ ~~Crawl Space~~ ☐ Basement w/plumbing ☐ Basement wo/plumbing

Comments:/Conditions: INSTALL 50% REDUCTION SYSTEM USING 48 PPBPS PANELS IN SIX EQUAL LENGTH LINES ON CONTOUR AS FLAGGED

Comments:/Conditions: House NOT installed Septic tank marked Red Toilets filled

INITIAL SITE SKETCH

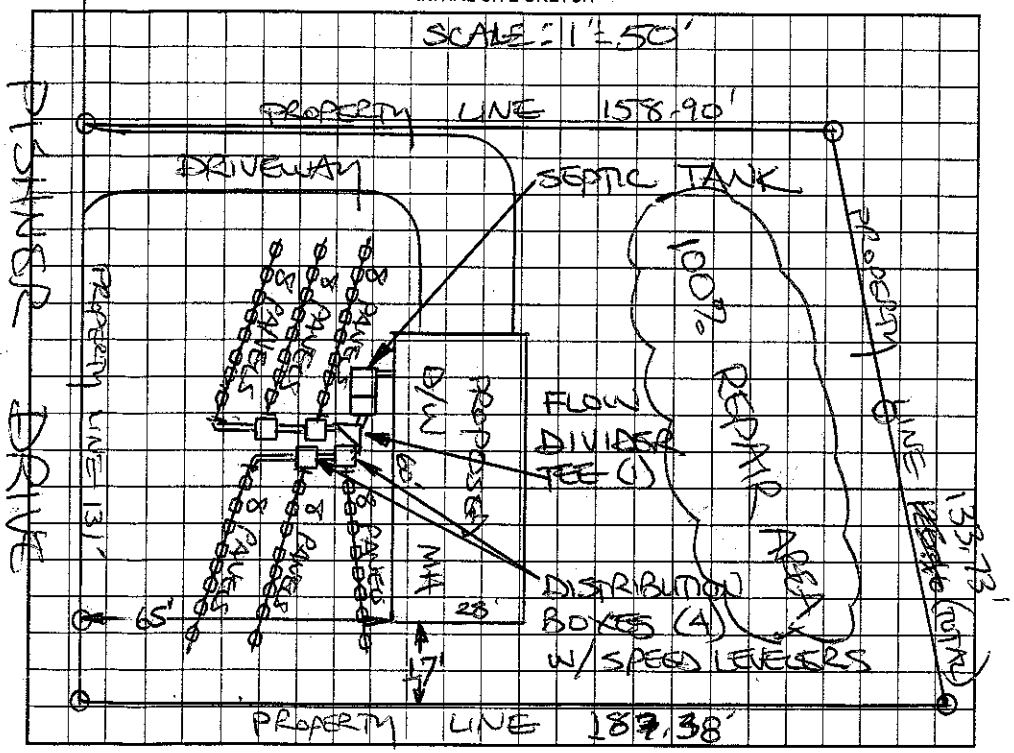

AS BUILT SKETCH

Permit can be suspended or revoked if any false information is supplied toward securing the permit/any unauthorized changes are made to the site/any unauthorized changes are made in the installation of the system. Improvement Permit with plat valid without expiration. Improvement Permit with site plan valid for sixty months. Authorization to Construct is valid for a period equal to that of Improvement Permit – not to exceed sixty months.

Signed: Fil Pishner date 7-3-02 Installed by: Sammy Rogers

Improvement Permit by: STEVE HEDRICK date 6-28-02 Operation Permit by: Kelly Cox date 2-28-07

Authorization to Construct by: STEVE HEDRICK date 6-28-02 Existing System Inspection by: _____ date _____

HEALTH DEPT. COPY: WHITE OWNER COPY (FINAL): YELLOW OWNER COPY (INITIAL): PINK