IREDELL COUNTY HEALTH DEPARTMENT

STATESVILLE 704-878-5305 (C1) MOORESVILLE 704-664-5281

IMPROVEMENT PERMIT / AUTHORIZATION TO CONSTRUCT / OPERATION PERMIT / EXISTING SYSTEM INSPECTION

PERMIT# 105646 PIN# 4779-68-5129.2 DATE 4-30-02

OWNER OR CONTRACTOR FILBERT W. PISHNER PHONE: Business Home 704-546-7478

ADDRESS 141 ESTHER DR HARMONY NC 28634

LOCATION US 21 North, TR MT. BETHEL RD, TL PISHNER DRIVE, PS AT END ON RIGHT

SUBDIVISION PISHNER EST. BLOCK / SECTION LOT 2 LOT AREA 0.522 ACRE SITE CLASS PS DESIGN FLOW 480 L.T.A.R. 0.40 GPD/FT²

Septic Tank: 1000 Gallons: STB 760 Date 5-28-01

Pump Tank: Gallons: PT Date

Pump Make: Model Serial No.

Nitrification Field: No Fields 1 Square Feet 1200 Linear Feet 400

No Lines FIVE Trench Width 36" Max Trench Bottom Depth 36" Gravel Depth

☑ New System ☐ Repair System Type: I II III IV V VI

System Description: CONVENTIONAL GRAVITY

Repair System Description: CONV. GRAVITY pump

Maintenance Agreement Required: ☐ Yes ☑ No

☐ Slab ☐ Crawl Space ☐ Basement w/plumbing ☐ Basement wo/plumbing

☑ House/Mod Home ☐ Mobile Home ☐ Business ☐ Other


No. Bedrooms 4 No. Bathrooms 2 No Employees

Water Supply: ☐ Individual ☑ Public ☐ Community

Comments/Conditions: INSTALL LINES ON CONTOUR AS FLAGGED USING 12" STONE

Comments/Conditions: SEPTIC TANK WITH RISERS INSTALLED USING "ZABEL" FILTER

INITIAL SITE SKETCH

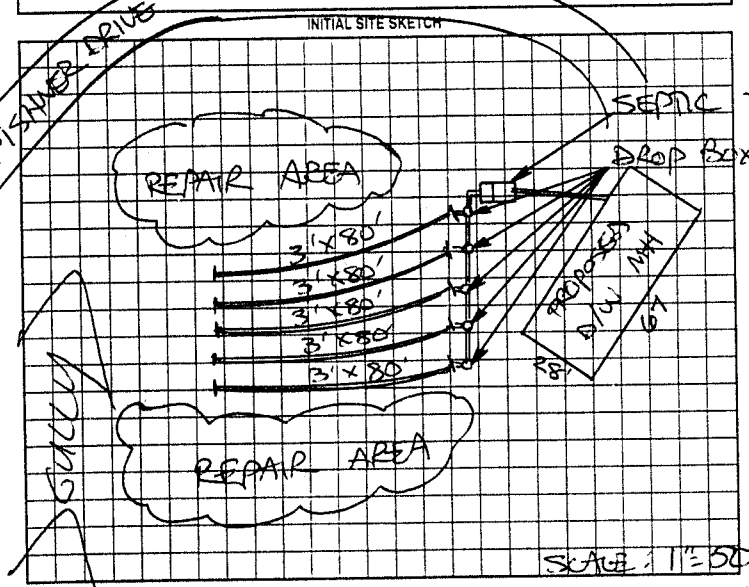

AS BUILT SKETCH

SYSTEM INSTALLED ACCORDING TO INITIAL SITE SKETCH

Permit can be suspended or revoked if any false information is supplied toward securing the permit/any unauthorized changes are made to the site any unauthorized changes are made in the installation of the system. Improvement Permit with plat valid without expiration. Improvement Permit with site plan valid for sixty months. Authorization to Construct is valid for a period equal to that of Improvement Permit – not to exceed sixty months.

Signed: W. Fil Pishner date 4-30-02 Installed by: BRENT GALLIHER

Improvement Permit by: STEVE HEDRICK date 4-30-02 Operation Permit by: STEVE HEDRICK date 5-3-02

Authorization to Construct by: STEVE HEDRICK date 4-30-02 Existing System Inspection by: date

HEALTH DEPT. COPY: WHITE OWNER COPY (FINAL): YELLOW OWNER COPY (INITIAL): PINK