22734

IREDELL COUNTY HEALTH DEPARTMENT

STATESVILLE 704-878-5305 MOORESVILLE 704-664-5281

IMPROVEMENT PERMIT / CERTIFICATE OF COMPLETION / OPERATION PERMIT / EXISTING SYSTEM INSPECTION

PROPERTY DESCRIPTION NO. 22734 DATE 5-28-96 TAX MAP NO. 12H-1-A-19 & 20 Watershed: ☐ Yes ☑ No

OWNER OR CONTRACTOR REBECCA MITCHELL PHONE: Business 838-8900 Home 872-5312

ADDRESS 310 HOLLAND DRIVE STATESVILLE, NC 28677

LOCATION US 21 N, TR GLENWOOD VALLEY ON RIGHT JUST PAST SUGAR PLUM LANE

SUBDIVISION GLENWOOD I BLOCK / SECTION ____ LOT 19 & 20 LOT AREA 19420 SITE CLASS. PS DESIGN FLOW 360 L.T.A.R. 0.33 GAL/SQ FT

Septic Tank: 1000 Gallons; STB 794 Date 1-24-97
Pump Tank: ____ Gallons; PT ____ Date ____
Pump Make: ____ Model ____ Serial No. ____
Nitrification Field: No Fields 1 Square Feet 1080 Linear Feet 360
No Lines 3 Trench Width 36" Max Trench Bottom Depth 18-22" Gravel Depth 12"

☑ New System ☐ Repair System Type: I, II, III, IV, V, VI
System Description: CONV. GRAVITY
Repair System Description: CONV. GRAVITY
Maintenance Agreement Required: ☐ Yes ☑ No


☑ House/Mod. Home No. Bedrooms 3
☐ Mobile Home No. Bathrooms 2
☐ Business No. Employees ____
☐ Other ____
☐ Slab ☑ Crawl Space ☐ Basement w/plumbing ☐ Basement wo/plumbing

Water Supply: ☐ Individual ☐ Community ☑ Public


Comments: (1) KEEP SYSTEM MINIMUM 5' FROM HOUSE 10' FROM WATER LINE AND PROPERTY LINES (2) INSTALL LINES ON CONTOUR AS PLANNED NO DEEPER THAN 22"

Comments:

INITIAL SITE SKETCH

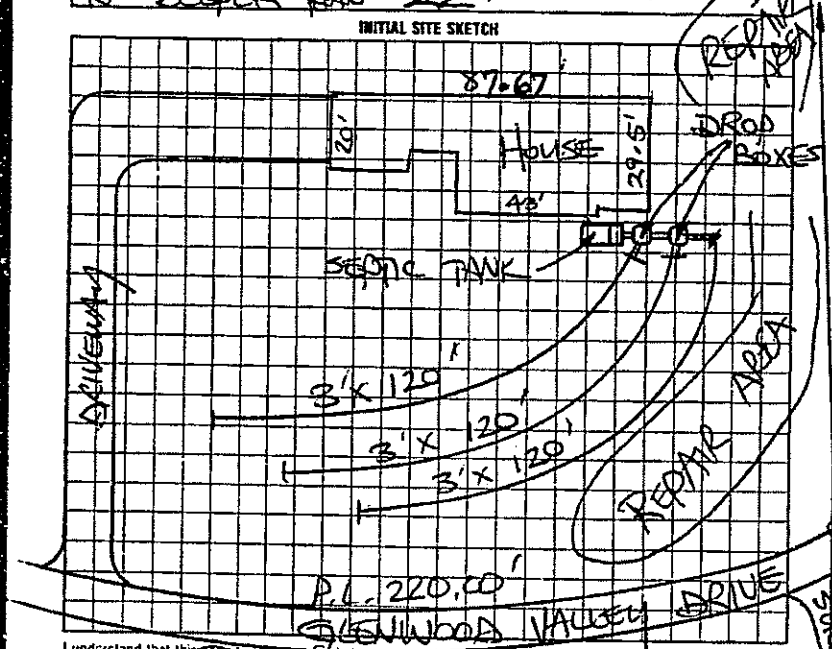

AS BUILT SKETCH

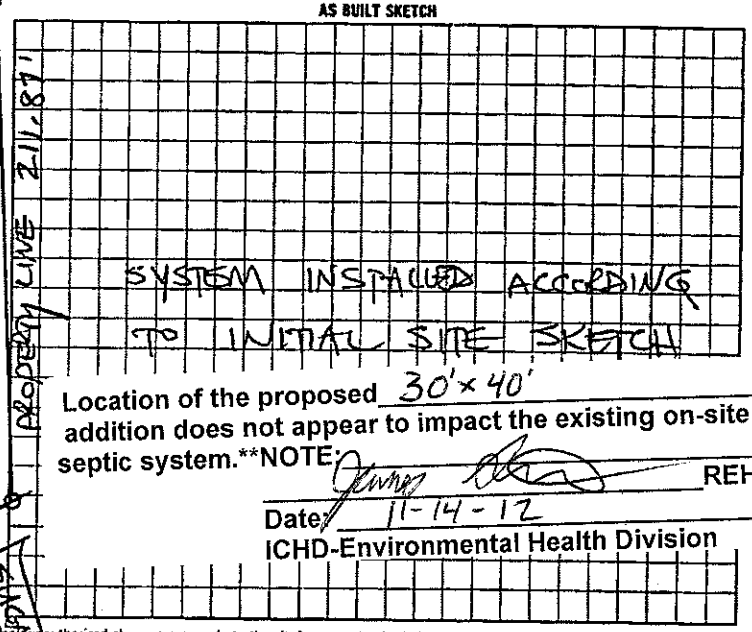

Location of the proposed 30'×40' addition does not appear to impact the existing on-site septic system.**NOTE:

REHS

Date: 11-14-12

ICHD-Environmental Health Division

I understand that this permit can be suspended or revoked if any false information is supplied toward securing the permit and/or unauthorized changes are made to the site/any unauthorized changes are made in the installation of the system.

Authorization to Construct is valid five (5) years from date of issuance. Improvement Permit has no expiration date.

Signed: Rebecca Mitchell

Improvement Permit by: STEVE HEDRICK date 5-28-96

AUTHORIZATION TO CONSTRUCT: STEVE HEDRICK date 5-28-96

Installed by: JAMES HUDLER

Certificate of Completion by: ____ date ____

Operation Permit by STEVE HEDRICK date 3-18-97

HEALTH DEPT COPY WHITE | INSPECTION COPY (FINAL) GREEN | OWNER COPY (FINAL) YELLOW | INSPECTION COPY (INITIAL) PINK | OWNER COPY (INITIAL) GOLD

9 E 6 1 0 0