IREDELL COUNTY HEALTH DEPARTMENT

STATESVILLE 704-878-5305 (LT) MOORESVILLE 704-664-5281

IMPROVEMENT PERMIT / AUTHORIZATION TO CONSTRUCT / OPERATION PERMIT / EXISTING SYSTEM INSPECTION

PERMIT# 115334 PIN# ~~4779-59-4778~~ 4779-59-4866 DATE 9-15-03

OWNER OR CONTRACTOR ED & BEVERLY HEDRICK PHONE: Business 704-546-7355 Home 704-546-2285

ADDRESS 119 LEGACY HARMONY NC 28634

LOCATION 21 NORTH (R) GLENWOOD VALLEY DRIVE, ATEND ON LEFT

SUBDIVISION GLENWOOD BLOCK / SECTION (A) LOT ~~#416~~ (17) LOT AREA .98 AC SITE CLASS. PS DESIGN FLOW 360 L.T.A.R. .3

Septic Tank: 1000 Gallons; STB 760 Date 2-22-04

Pump Tank: _____ Gallons; PT _____ Date _____

Pump Make: _____ Model _____ Serial No. _____

Nitrification Field: No Fields 1 Square Feet 1200' Linear Feet 400'

No Lines 4X100' Trench Width 36" Max Trench Bottom Depth 36" Gravel Depth 12"

[X] New System [ ] Repair System Type: I, (II), III, IV, V, VI

System Description: CON GRAV

Repair System Description: GRAV 25% RED

Maintenance Agreement Required: [ ] Yes [X] No

[X] House/Mod. Home No. Bedrooms 3

[ ] Mobile Home No. Bathrooms 2.5

[ ] Business No. Employees ____

[ ] Other ____ 1/2


[ ] Slab [ ] Crawl Space [X] Basement w/plumbing [X] Basement wo/plumbing

Water Supply: [ ] Individual [X] Public [ ] Community

Comments:/Conditions: (1) BOTH LOTS NEEDS TO BE DEEDED AS ONE LOT BY OP CAN BE SIGNED OFF ON (2) HOUSE & SEPTIC IS ENTIRELY FLAGGED OUT (3) INSTALL LINES ON CONTOURS & MAINTAIN SETBACKS,

Comments:/Conditions: SEPTIC TANK WITH RISERS INSTALLED WITH "POLYLOK" (RED) FILTER

INITIAL SITE SKETCH

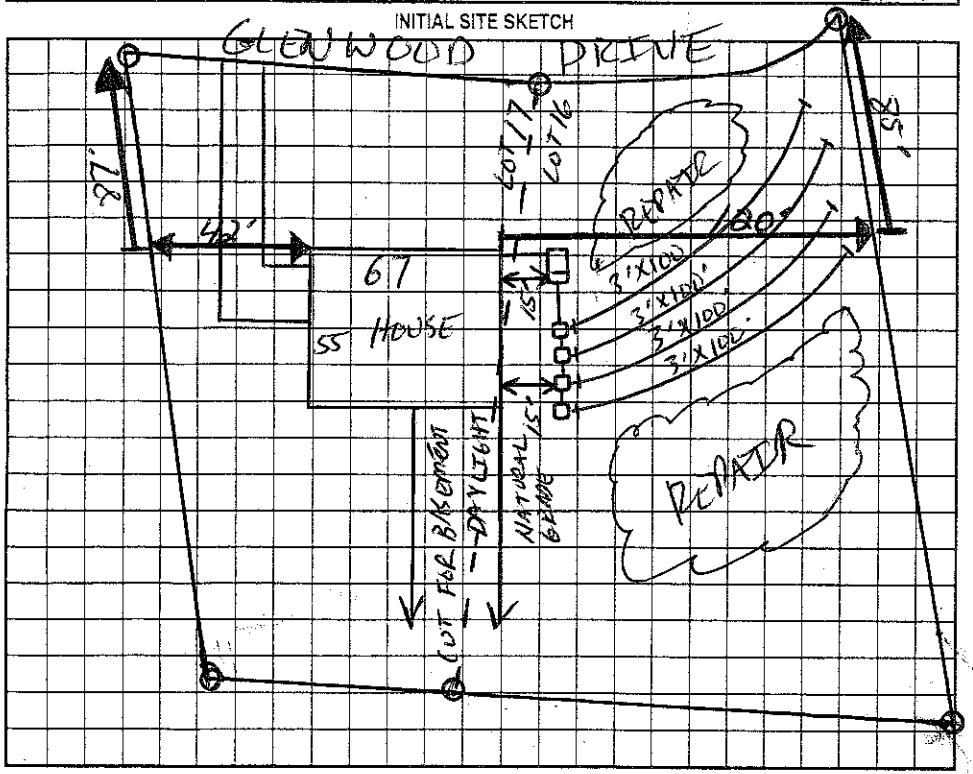

AS BUILT SKETCH

SYSTEM INSTALLED ACCORDING TO INITIAL SITE SKETCH

Permit can be suspended or revoked if any false information is supplied toward securing the permit/any unauthorized changes are made to the site/any unauthorized changes are made in the installation of the system. Improvement Permit with plat valid without expiration. Improvement Permit with site plan valid for sixty months. Authorization to Construct is valid for a period equal to that of Improvement Permit – not to exceed sixty months.

Signed: Benny Hedrick date 9-16-03 Installed by: BRENT GALLIHER

Improvement Permit by: [signature] date 9-15-03 Operation Permit by: STEVE HENRICK date 8-4-04

Authorization to Construct by: [signature] date 9-15-03 Existing System Inspection by: _____ date _____

HEALTH DEPT. COPY: WHITE OWNER COPY (FINAL): YELLOW OWNER COPY (INITIAL): PINK