IREDELL COUNTY HEALTH DEPARTMENT

STATESVILLE 704-878-5305 MOORESVILLE 704-664-5281

IMPROVEMENT PERMIT / AUTHORIZATION TO CONSTRUCT / OPERATION PERMIT / EXISTING SYSTEM INSPECTION

PERMIT# 128798 PIN# 4779-62-3108 DATE 5-25-05

OWNER OR CONTRACTOR WILLIAM & DENISE BOZARTH PHONE: Business (704) 539-4442 Home

ADDRESS 175 FLORA LN. HARMONY, NC 28634

LOCATION US21 N TR MT. BETHEL RD TR FLORA LN NEXT TO LAST LOT ON LEFT

SUBDIVISION Mt Bethel Estates BLOCK / SECTION II LOT 10 LOT AREA 2.36 SITE CLASS. PS DESIGN FLOW 360 L.T.A.R. 0.30 GPD/FT²

Septic Tank: 1000 Gallons; STB 794 Date 4-30-05
Pump Tank: Gallons; PT Date
Pump Make: Model Serial No.
Nitrification Field: No. Fields 1 Square Feet 1200 Linear Feet 300
No Lines FOUR (4) Trench Width 36" Max Trench Bottom Depth 24" Gravel Depth N/A

☑ New System ☐ Repair System Type: I (II) III IV, V, VI
System Description: GRAVITY 25% REDUCTION
Repair System Description: LP PPBPS 50% REDUCTION
Maintenance Agreement Required: ☐ Yes ☑ No


☐ House/Mod. Home No. Bedrooms 3
☑ Mobile Home No. Bathrooms
☐ Business No. Employees
☐ Other
☐ Slab ☑ Crawl Space ☐ Basement w/plumbing ☐ Basement wo/plumbing

Water Supply: ☐ Individual ☑ Public ☐ Community


Comments:/Conditions: ① INSTALL LINES 24" ON CONTOUR ② INSTALL SUBSURFACE INTERCEPTOR DRAIN 36" TO DAYLIGHT ③ MAINTAIN ALL SETBACKS ④ PACK & FILL GULLIES — THIS MUST BE DONE BEFORE CA CAN BE ISSUED.

Comments:/Conditions: ① RED POLYLOK FILTER ② MARKER ON ST ③ E-Z FLOW ④ #57 STONE IN FRENCH DRAIN

INITIAL SITE SKETCH

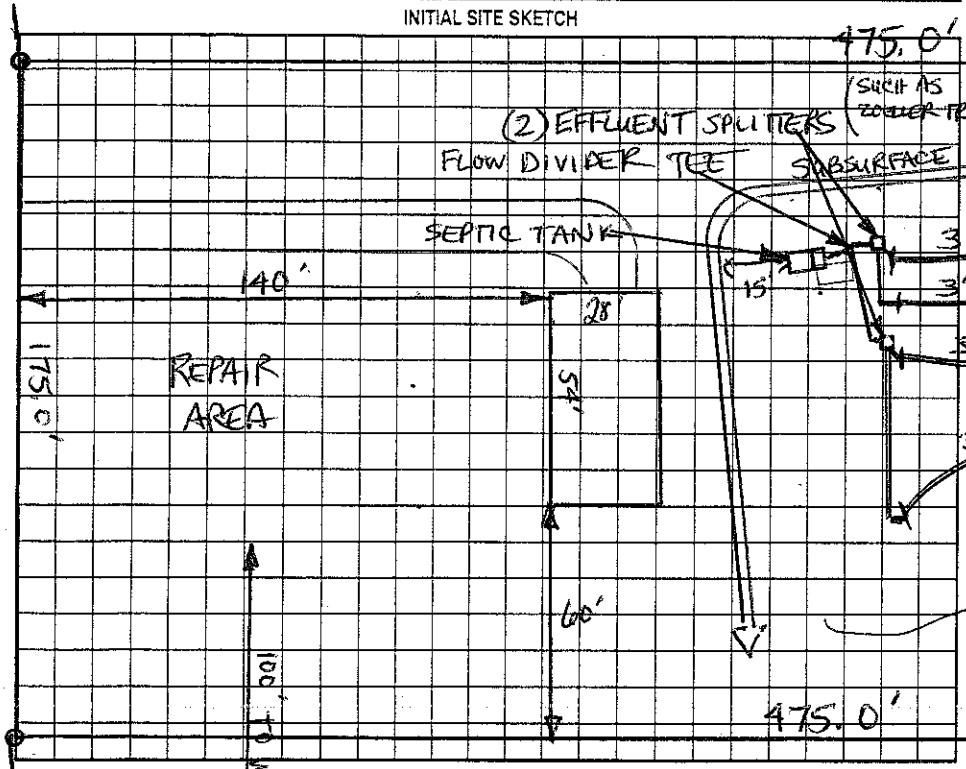

AS BUILT SKETCH

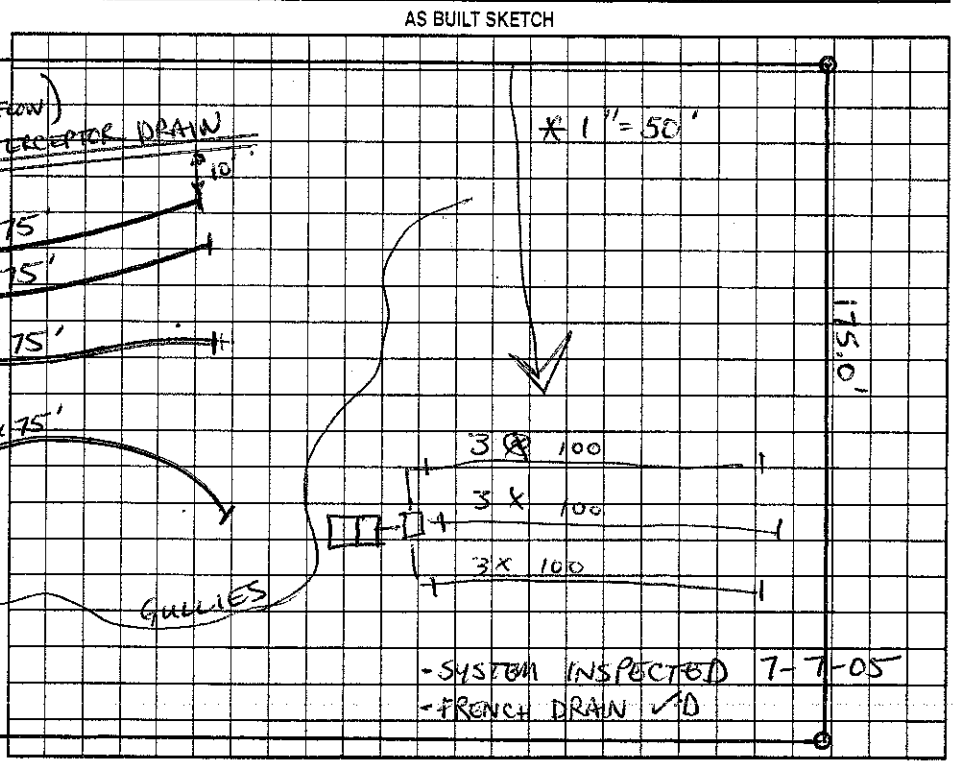

FLORA LANE

Permit can be suspended or revoked if any false information is supplied toward securing the permit/any unauthorized changes are made to the site/any unauthorized changes are made in the installation of the system. Improvement Permit with plat valid without expiration. Improvement Permit with site plan valid for sixty months. Authorization to Construct is valid for a period equal to that of Improvement Permit – not to exceed sixty months.

Signed: William & Bozarth date 5-25-05 Installed by: SIPE LANDSCAPE & DESIGN

Improvement Permit by: Christopher M. Sherrill, RS, LSS date 5-25-05 Operation Permit by: Christopher M. Sherrill, RS, LSS date 7-15-05

Authorization to Construct by: Christopher M. Sherrill, RS, LSS date 6-13-05 Existing System Inspection by: date

HEALTH DEPT. COPY: WHITE OWNER COPY (FINAL): YELLOW OWNER COPY (INITIAL): PINK