60926 THIS PERMIT VOIDS PREVIOUS ISSUED 3-19-96

IREDELL COUNTY HEALTH DEPARTMENT

STATESVILLE 704-878-5305 MOORESVILLE 704-664-5281

IMPROVEMENT PERMIT / CERTIFICATE OF COMPLETION / OPERATION PERMIT / EXISTING SYSTEM INSPECTION

60926

PROPERTY DESCRIPTION NO. 23292 DATE 5-24-96 TAX MAP NO. 12H-4-A-9 Watershed: ☐ Yes ☒ No

OWNER OR CONTRACTOR BOBBY MILLER PHONE: Business Home 528-6503

ADDRESS 323 STATE PARK RD TROUTMAN NC 28166

LOCATION US 21 N TR MT. BETHEL RD, TR FLORA LANE, 6TH LOT ON LEFT

SUBDIVISION MT. BETHEL BLOCK / SECTION LOT 9 LOT AREA ~175-500' SITE CLASS. PS DESIGN FLOW 360 L.T.A.R. 0.306 GPD/FT²

Septic Tank: 1000 Gallons; STB 794 Date 3-19-96

Pump Tank: Gallons; PT Date

Pump Make: Model Serial No.

Nitrification Field: No Fields 1 Square Feet 1200 Linear Feet 400

No Lines 4 Trench Width 36" Max Trench Bottom Depth 18"-36" Gravel Depth 12"

☒ New System ☐ Repair System Type: I, II, III, IV, V, VI

System Description: CONV. GRAVITY

Repair System Description: CONV. GRAVITY

Maintenance Agreement Required: ☐ Yes ☒ No

☐ House/Mod. Home No. Bedrooms 3

☒ Mobile Home No. Bathrooms 2½

☐ Business No. Employees

☐ Other


☐ Slab ☒ Crawl Space ☐ Basement w/plumbing ☐ Basement wo/plumbing

Water Supply: ☐ Individual ☐ Community ☒ Public


Comments:

Comments:

INITIAL SITE SKETCH

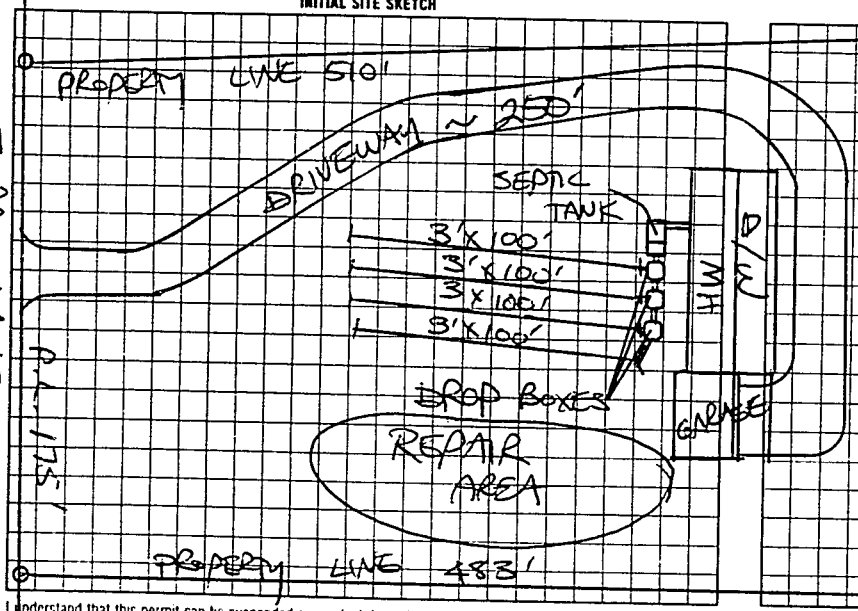

AS BUILT SKETCH

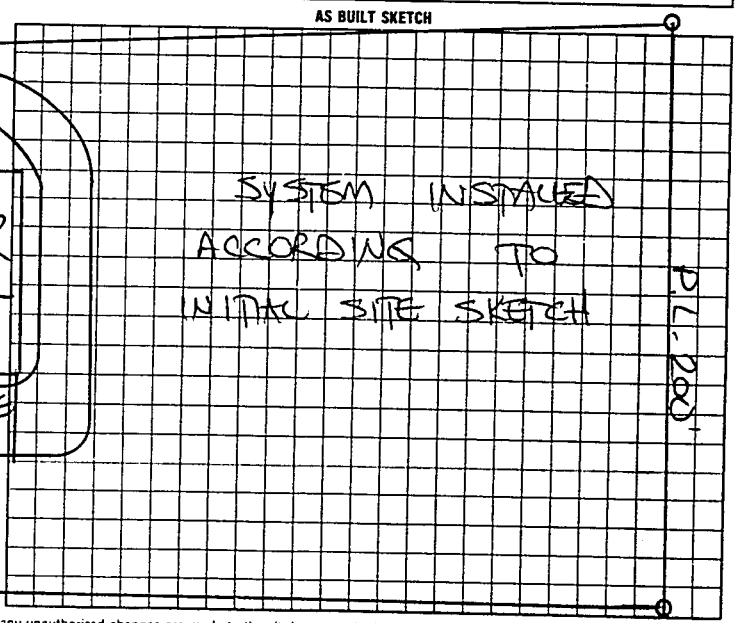

I understand that this permit can be suspended or revoked if any false information is supplied toward securing the permit/any unauthorized changes are made to the site/any unauthorized changes are made in the installation of the system. Authorization to Construct is valid five (5) years from date of issuance. Improvement Permit has no expiration date.

Signed: X Bobby Miller

Improvement Permit by: STEVE HEDRICK date 5-24-96

Authorization to Construct: STEVE HEDRICK date 5-24-96

Installed by: WES LYTTON

Certificate of Completion by: date

Operation Permit by: STEVE HEDRICK date 7-9-96

HEALTH DEPT COPY WHITE INSPECTION COPY (FINAL) GREEN OWNER COPY (FINAL) YELLOW INSPECTION COPY (INITIAL) PINK