IREDELL COUNTY HEALTH DEPARTMENT

STATESVILLE 704-878-5305 MOORESVILLE 704-664-5281

IMPROVEMENT PERMIT / AUTHORIZATION TO CONSTRUCT / OPERATION PERMIT / EXISTING SYSTEM INSPECTION

PERMIT# 72691 PIN# 4779 62 5667 DATE 5-4-98

OWNER OR CONTRACTOR Chris Chambers PHONE: Business Home 546 7713

ADDRESS 169 Barnard Mill Rd Hamptonville, N.C.

LOCATION 154 Flora Ln 2 IN TR mt Bethel Rd/TR Flora Ln 5th lot Rt.

SUBDIVISION mt Bethel Est BLOCK / SECTION LOT 16 LOT AREA 2 acres SITE CLASS. PS DESIGN FLOW 360 L.T.A.R. 1.33

Septic Tank: 1000 Gallons; STB Date 6-2098

Pump Tank: Gallons; PT Date

Pump Make: Model Serial No.

Nitrification Field: No Fields 1 Square Feet 1080 Linear Feet 360

No Lines 3 Trench Width 36" Max Trench Bottom Depth 36" Gravel Depth 12"

☑ New System ☐ Repair System Type: I, ☐ II, III, IV, V, VI

System Description: Conv. Gravity

Repair System Description: " "

Maintenance Agreement Required: ☐ Yes ☑ No

☐ House/Mod. Home No. Bedrooms 3

☑ Mobile Home No. Bathrooms 2

☐ Business No. Employees

☐ Other


☐ Slab ☑ Crawl Space ☐ Basement w/plumbing ☐ Basement wo/plumbing

Water Supply: ☐ Individual ☑ Public ☐ Community


Comments:/Conditions:

Comments:/Conditions:

INITIAL SITE SKETCH

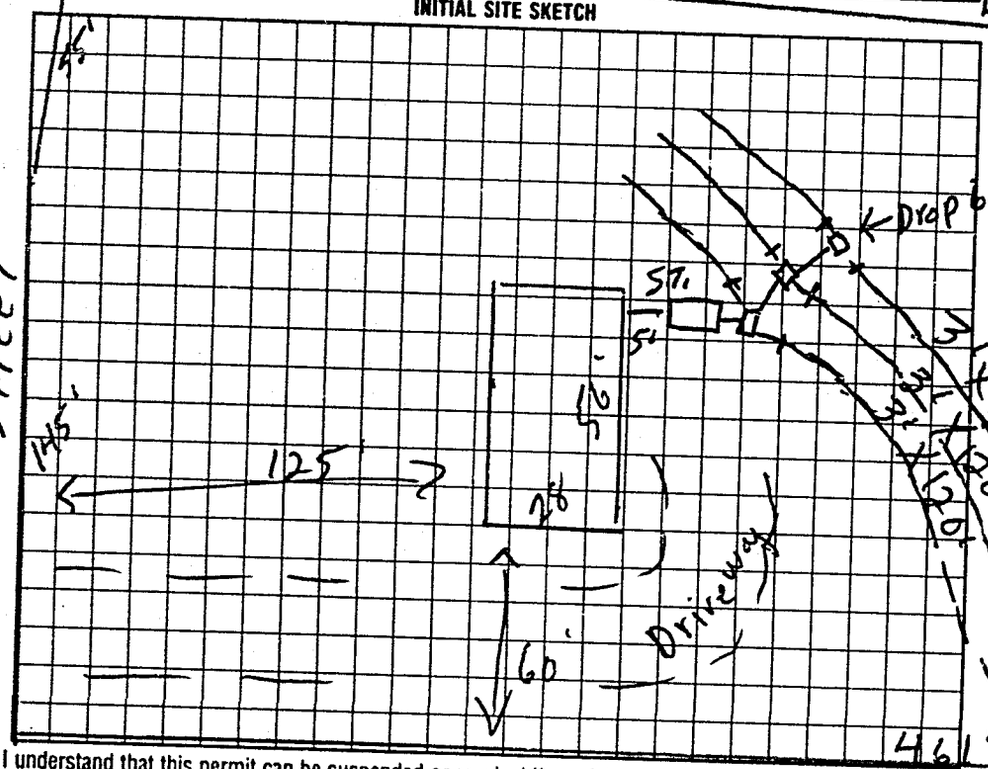

AS BUILT SKETCH

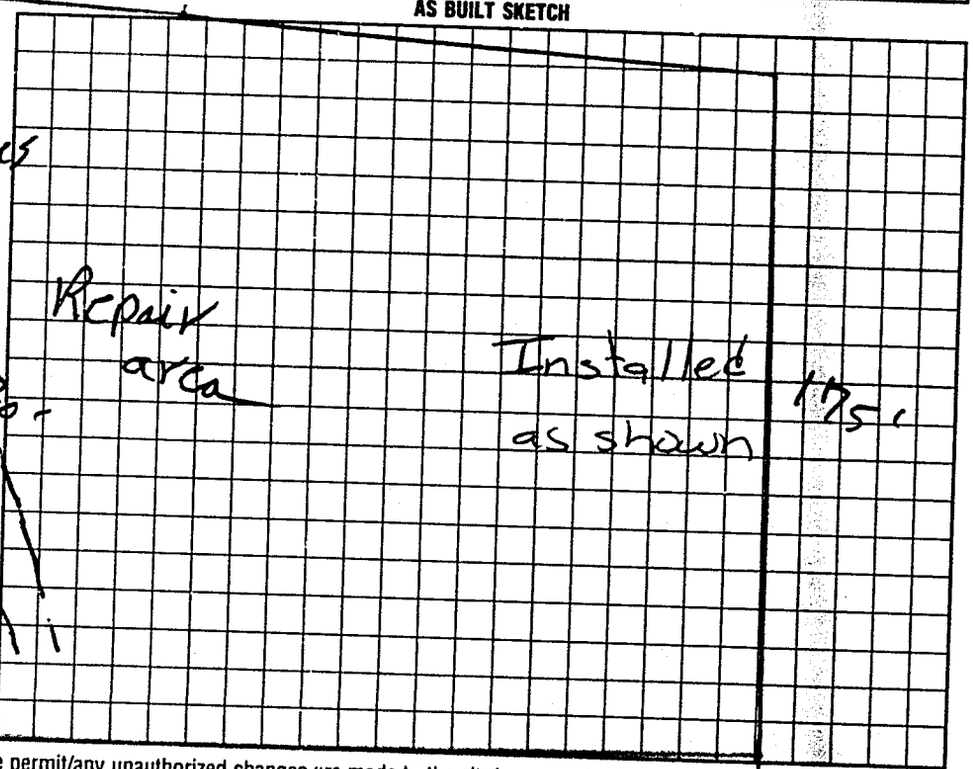

I understand that this permit can be suspended or revoked if any false information is supplied toward securing the permit/any unauthorized changes are made to the site/any unauthorized changes are made in the installation of the system. Improvement Permit with plat valid without expiration. Improvement Permit with site plan valid for sixty months. Authorization to Construct is valid for a period equal to that of Improvement Permit – not to exceed sixty months.

Signed: Candace Swaim date 5-4-98

Improvement Permit by: T.C. Moore date 5-4-98

Authorization to Construct by: T.C. Moore date 5-4-98

Installed by: HB Salmons

Operation Permit by: Mat C.O.T.B date 7-24-98

Existing System Inspection by: date

HEALTH DEPT. COPY WHITE INSPECTION COPY (FINAL) GREEN OWNER COPY (FINAL) YELLOW INSPECTION COPY (INITIAL) PINK OWNER COPY (INITIAL) GOLD