62473

IREDELL COUNTY HEALTH DEPARTMENT

STATESVILLE 704-878-5305 MOORESVILLE 704-664-5281

IMPROVEMENT PERMIT / CERTIFICATE OF COMPLETION / OPERATION PERMIT / EXISTING SYSTEM INSPECTION

PROPERTY DESCRIPTION NO. 24434 DATE 7-24-96 TAX MAP NO. 12H-4-A-8 Watershed: ☐ Yes ☐ No

OWNER OR CONTRACTOR Sunwood Builders PHONE: Business 872 0921 Home

ADDRESS PO Box 5nn Statesville

LOCATION 012 Mocksville TL Bethel ch Rd TL Flora Lane 5th lot left

SUBDIVISION Mt Bethel PK BLOCK / SECTION LOT 8 LOT AREA 2 1/2 acres SITE CLASS. PS DESIGN FLOW 360 L.T.A.R. .3

Septic Tank: 1000 Gallons; STB 012 Date 5/20/96

Pump Tank: Gallons; PT Date

Pump Make: Model Serial No.

Nitrification Field: No Fields 1 Square Feet 1200 Linear Feet 400

No Lines 4 Trench Width 36" Max Trench Bottom Depth 36" Gravel Depth 12"

☑ New System ☐ Repair System Type: I, II, III, IV, V, VI

System Description: Conv. Gravity

Repair System Description:

Maintenance Agreement Required: ☐ Yes ☑ No

☐ House/Mod. Home No. Bedrooms 3

☑ Mobile Home No. Bathrooms 2

☐ Business No. Employees

☐ Other


☐ Slab ☐ Crawl Space ☐ Basement w/plumbing ☐ Basement wo/plumbing

Water Supply: ☐ Individual ☐ Community ☑ Public

Comments:


Comments: SYSTEM INSTALLED AS SHOWN

INITIAL SITE SKETCH

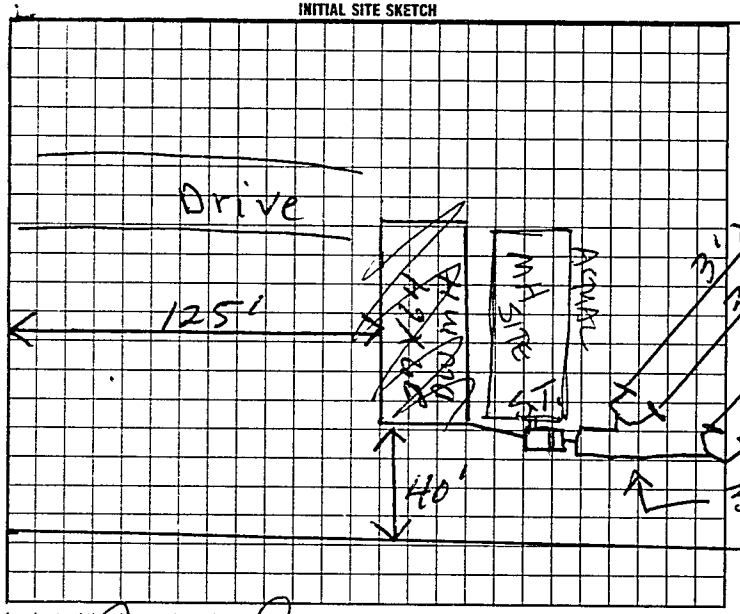

AS BUILT SKETCH

623'

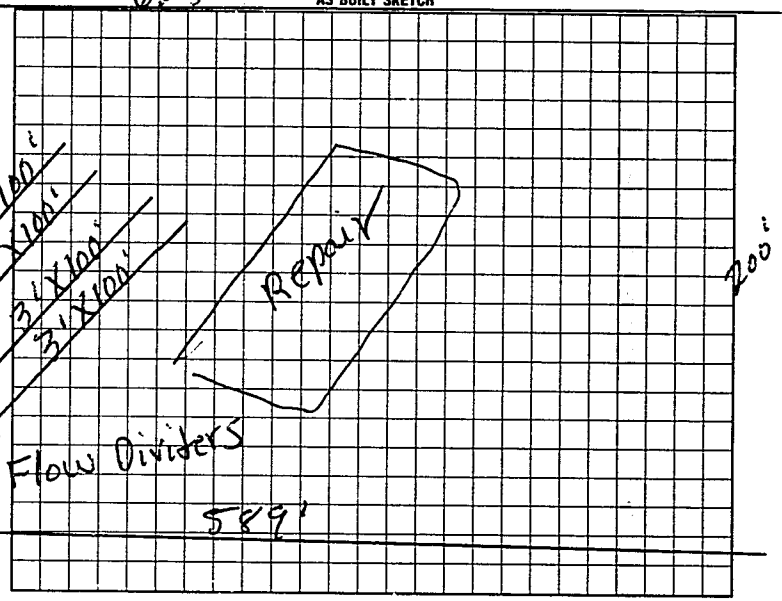

I understand that this permit can be suspended or revoked if any false information is supplied toward securing the permit/any unauthorized changes are made to the site/any unauthorized changes are made in the installation of the system.

Signed: Perry W. Graham

Improvement Permit by: P. C. Moore date 7-24-96

Authorization to Existing System Inspection by: P. C. Moore date 7-24-96

Installed by: TOMMY FRYE

Certificate of Completion by: date

Operation Permit by: STEVE HEDRICK date 8-8-96

TO COUNTY HEALTH DEPT. COPY: WHITE INSPECTION COPY (FINAL): GREEN OWNER COPY (FINAL): YELLOW INSPECTION COPY (INITIAL): PINK OWNER COPY (INITIAL): GOLD

Authorization to Count Expires 60 mos from issue

0024233