02474

IREDELL COUNTY HEALTH DEPARTMENT

STATESVILLE 704-878-5305 MOORESVILLE 704-664-5281

IMPROVEMENT PERMIT / CERTIFICATE OF COMPLETION / OPERATION PERMIT / EXISTING SYSTEM INSPECTION

PROPERTY DESCRIPTION NO. 24311 DATE 7-24-96 TAX MAP NO. 12H-4-A-17 Watershed: ☐ Yes ☐ No

OWNER OR CONTRACTOR Sunwood PHONE: Business 8720921 Home

ADDRESS PO BOX 5477 Sta.

LOCATION Old mock TL Bethel Ch Rd TL Flora Ln 4th lot RT

SUBDIVISION Mt Bethel Est. BLOCK / SECTION LOT 17 LOT AREA 2 acres SITE CLASS. PS DESIGN FLOW 360 L.T.A.R. .13

Septic Tank: 1000 Gallons; STB 1012 Date 5-20-96 ☑ New System ☐ Repair System Type: I II III, IV, V, VI

Pump Tank: Gallons; PT Date System Description: Conv. Gravity

Pump Make: Model Serial No. Repair System Description:

Nitrification Field: No Fields 1 Square Feet 1200 Linear Feet 400 Maintenance Agreement Required: ☐ Yes ☑ No

No Lines 4 Trench Width 36" Max Trench Bottom Depth 36" Gravel Depth 12" ☐ Slab ☑ Crawl Space ☐ Basement w/plumbing ☐ Basement wo/plumbing


☐ House/Mod. Home No. Bedrooms 3
☑ Mobile Home No. Bathrooms 2
☐ Business No. Employees
☐ Other

Water Supply: ☐ Individual ☐ Community ☑ Public


Comments:

Comments: SYSTEM CHANGED DUE TO HOMEOWNER'S REQUEST TO MOVE MH FURTHER BACK ON LOT.

INITIAL SITE SKETCH

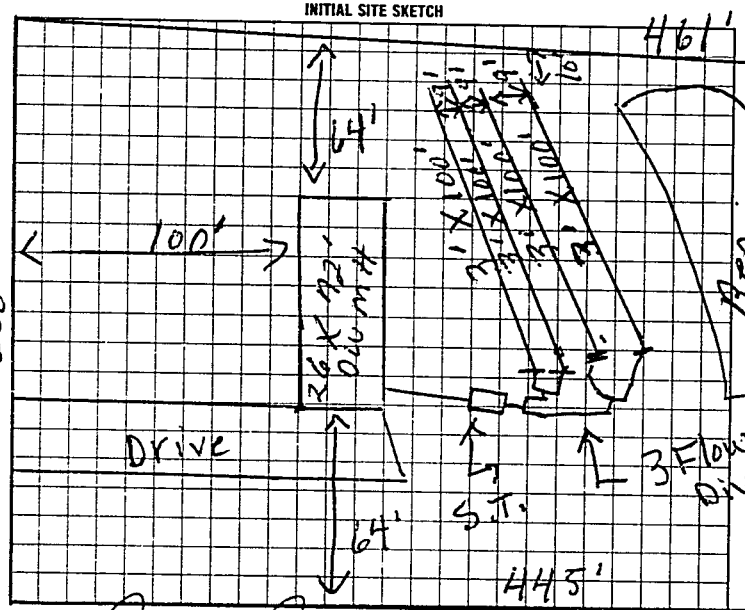

AS BUILT SKETCH

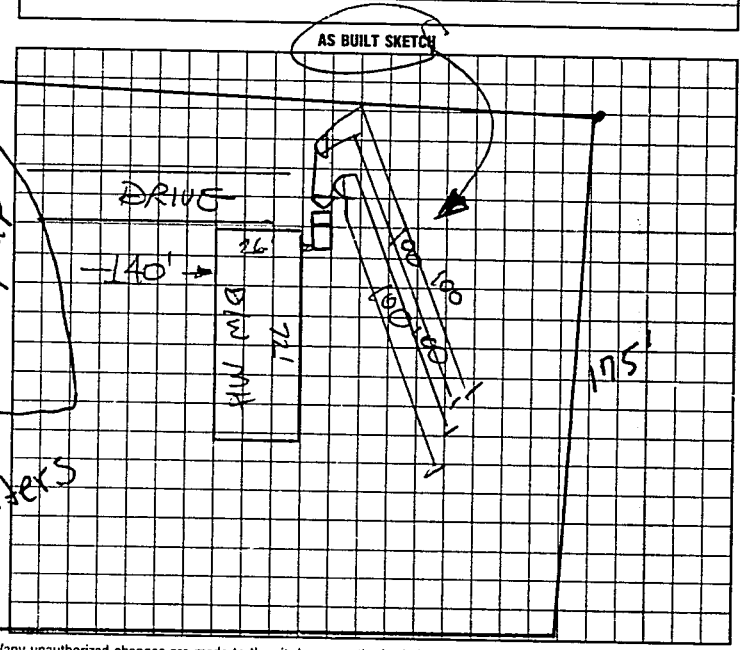

I understand that this permit can be suspended or revoked if any false information is supplied toward securing the permit/any unauthorized changes are made to the site/any unauthorized changes are made in the installation of the system.

Signed:

Improvement Permit by: L.C. Moore date 7-24-96

Existing System Inspection by: L.C. Moore date 7-24-96

Installed by: TOMMY FRYE

Certificate of Completion by: date

Operation Permit by: STEVE HEDRICK date 8-8-96

Authorization to Const. Authorization to Const. EXPIRES 60 DAYS FROM ISSUE

HEALTH DEPT. COPY: WHITE INSPECTION COPY (FINAL): GREEN OWNER COPY (FINAL): YELLOW INSPECTION COPY (INITIAL): PINK OWNER COPY (INITIAL): GOLD

9612200