61123

IREDELL COUNTY HEALTH DEPARTMENT

STATESVILLE 704-878-5305 MOORESVILLE 704-664-5281

IMPROVEMENT PERMIT / CERTIFICATE OF COMPLETION / OPERATION PERMIT / EXISTING SYSTEM INSPECTION

PROPERTY DESCRIPTION NO. 23416 DATE 4-19-96 TAX MAP NO. 12H-4-A-7 Watershed: ☐ Yes ☐ No

OWNER OR CONTRACTOR LAMAR W. POORE PHONE: Business _____ Home 528-3196

ADDRESS 114 SUTTON COURT STATESVILLE, NC 28677

LOCATION US 21 N TR BETHEL ROAD TR FLORA LANE, 4TH LOT ON LEFT

SUBDIVISION MT. BETHEL EST. BLOCK / SECTION _____ LOT 7 LOT AREA ~175x600' SITE CLASS PS DESIGN FLOW 360 L.T.A.R. 0.30 GPD/FT²

Septic Tank: 1000 Gallons; STB 794 Date 1-24-96
Pump Tank: _____ Gallons; PT _____ Date _____
Pump Make: _____ Model _____ Serial No. _____
Nitrification Field: No. Fields 1 Square Feet 1200 Linear Feet 400
No. Lines 5 Trench Width 36" Max Trench Bottom Depth 18-36" Gravel Depth 12"

☑ New System ☐ Repair System Type: I. II. III. IV. V. VI
System Description: CONVENTIONAL GRAVITY
Repair System Description: CONVENTIONAL GRAVITY
Maintenance Agreement Required: ☐ Yes ☑ No


☐ House/Mod. Home No. Bedrooms 3
☑ Mobile Home No. Bathrooms 2
☐ Business No. Employees ____
☐ Other _____
☐ Slab ☑ Crawl Space ☐ Basement w/plumbing ☐ Basement wo/plumbing

Water Supply: ☐ Individual ☐ Community ☑ Public

Comments:

Comments:

INITIAL SITE SKETCH

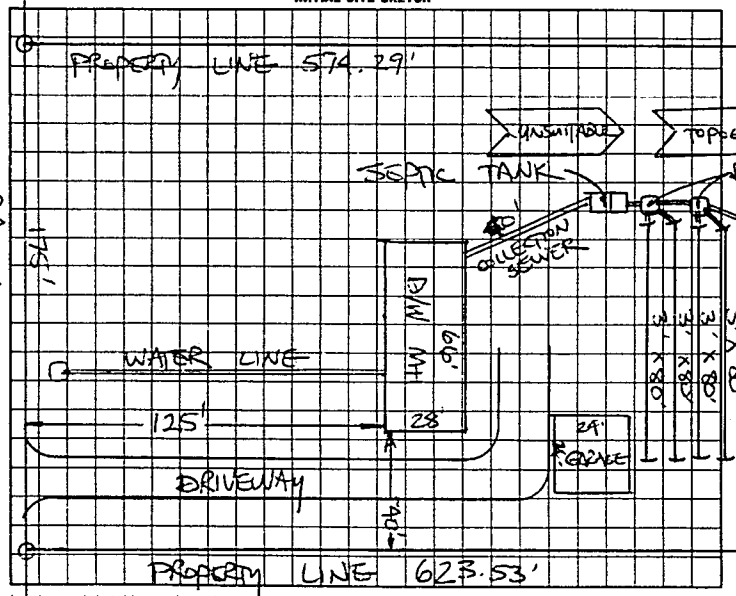

AS BUILT SKETCH

SYSTEM INSTALLED ACCORDING TO INITIAL SITE SKETCH

I understand that this permit can be suspended or revoked if any false information is supplied toward securing the permit/any unauthorized changes are made to the site/any unauthorized changes are made in the installation of the system.

AUTHORIZATION TO CONSTRUCT IS VALID FIVE (5) YEARS FROM DATE OF ISSUANCE. IMPROVEMENT PERMIT HAS NO EXPIRATION DATE.

Signed: X Lamar W. Poore

Installed by: A-1 BACKHOE

Improvement Permit by: STEVE HENRICK date 4-19-96

AUTHORIZATION TO CONSTRUCT
Existing System Inspection by: STEVE HENRICK date 4-19-96

~~Certificate of Completion by:~~ _____ date _____

Operation Permit by: STEVE HENRICK date 5-17-96

HEALTH DEPT COPY WHITE | INSPECTION COPY (FINAL) GREEN | OWNER COPY (FINAL) YELLOW | INSPECTION COPY (INITIAL) PINK | OWNER COPY (INITIAL) GOLD

000100