IREDELL COUNTY HEALTH DEPARTMENT

STATESVILLE 704-878-5305 MOORESVILLE 704-664-5281

IMPROVEMENT PERMIT / CERTIFICATE OF COMPLETION / OPERATION PERMIT / EXISTING SYSTEM INSPECTION

PROPERTY DESCRIPTION NO. 18567 DATE 5/25/94 TAX MAP NO. 12H-A-172 Watershed: ☐ Yes ☑ No

OWNER OR CONTRACTOR DONALD MILLS PHONE: Business Home 872-2374

ADDRESS P.O. BOX 5424 STVL, NC 28677

LOCATION US 21 N, TR BETHEL RD, TL SHAW RD, ON LEFT ~ 0.3 MILE

SUBDIVISION BLOCK / SECTION LOT LOT AREA 7.56 SITE CLASS. PS DESIGN FLOW 360 L.T.A.R. 0.40 GPD/FT²

Septic Tank: 1000 Gallons; STB 1012 Date 3/25/94

Pump Tank: Gallons; PT Date

Pump Make: Model Serial No.

Nitrification Field: No Fields 1 Square Feet 900 Linear Feet 300

No Lines 3 Trench Width 36" Max Trench Bottom Depth 18-36 Gravel Depth 12"

☑ New System ☐ Repair System Type: I, II, III, IV, V, VI

System Description: CONV. GRAVITY

Repair System Description: CONV. GRAVITY

Maintenance Agreement Required: ☐ Yes ☑ No

☐ House/Mod. Home No. Bedrooms 2

☑ Mobile Home No. Bathrooms 1

☐ Business No. Employees

☐ Other: PLANNED FOR 3BR


☐ Slab ☑ Crawl Space ☐ Basement w/plumbing ☐ Basement wo/plumbing

Water Supply: ☑ Individual ☐ Community ☐ Public WELL

Comments: ① KEEP SYSTEM MINIMUM 5' FROM MH & FUTURE ADDITION, 10' FROM PROPERTY LINE, 100' FROM WELL ② INSTALL LINES ON CONTOUR NO DEEPER THAN 36", 9' O.C. AS FLAGGED

Comments:

INITIAL SITE SKETCH

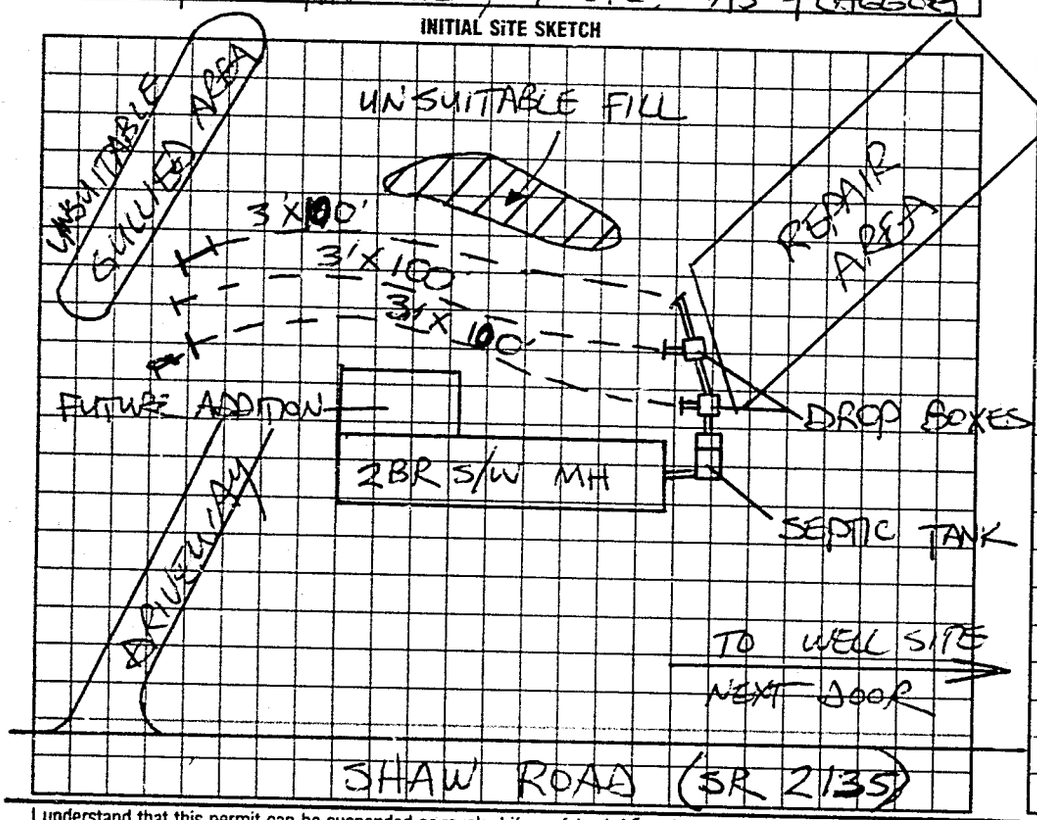

AS BUILT SKETCH

SYSTEM INSTALLED ACCORDING TO INITAL SITE SKETCH

I understand that this permit can be suspended or revoked if any false information is supplied toward securing the permit/any unauthorized changes are made to the site/any unauthorized changes are made in the installation of the system. Improvement Permit is valid for 60 months from date of issuance..

Signed: X Donald E. Mills

Improvement Permit by: STEVE HEDRICK date 5/25/95

Existing System Inspection by: date

Installed by: JEFF HURLBUT / JR. HARTNESS

Certificate of Completion by: STEVE HEDRICK date 6/29/94

Operation Permit by: date

HEALTH DEPT. COPY: WHITE INSPECTION COPY (FINAL): GREEN OWNER COPY (FINAL): YELLOW INSPECTION COPY (INITIAL): PINK OWNER COPY (INITIAL): GOLD