IREDELL COUNTY HEALTH DEPARTMENT

STATESVILLE 704-878-5305 MOORESVILLE 704-664-5281

IMPROVEMENT PERMIT / AUTHORIZATION TO CONSTRUCT / OPERATION PERMIT / EXISTING SYSTEM INSPECTION

PERMIT# 080466 PIN# 4779 68 7196 DATE 7-24-2000

OWNER OR CONTRACTOR FILBERT FISHNER PHONE: Business Home 546-7478

ADDRESS 126 HORIZON DRIVE, STATESVILLE, NC 28625

LOCATION US 21 N, TR BETHEL ROAD, TL ESTER LANE, AT END OF CUL-DE-SAC

SUBDIVISION BLOCK / SECTION LOT LOT AREA 55.54 Acres SITE CLASS: PS1 DESIGN FLOW 360 L.T.A.R. 0.30 gpd/ft²

Septic Tank: 1000 Gallons; STB 620 Date 7-6-00

Pump Tank: Gallons; PT Date

Pump Make: Model Serial No.

Nitrification Field: No Fields 1 Square Feet 1200 Linear Feet 400

No Lines FOUR Trench Width 36" Max Trench Bottom Depth 36" Gravel Depth 12"

☑ New System ☐ Repair System Type: I, (II), III, IV, V, VI

System Description: CONVENTIONAL, GRAVITY

Repair System Description: CONV. GRAVITY

Maintenance Agreement Required: ☐ Yes ☑ No

☑ House/Mod. Home No. Bedrooms 3

☐ Mobile Home No. Bathrooms 2

☐ Business No. Employees

☐ Other


☐ Slab ☑ Crawl Space ☐ Basement w/plumbing ☐ Basement wo/plumbing

Water Supply: ☐ Individual ☑ Public ☐ Community

Comments/Conditions: THIS PERMIT VOIDS PREVIOUS PERMIT ISSUED 1-12-2000

Comments/Conditions: SEPTIC TANK WITH RISERS INSTALLED USING "TUFFITE" FILTER

INITIAL SITE SKETCH

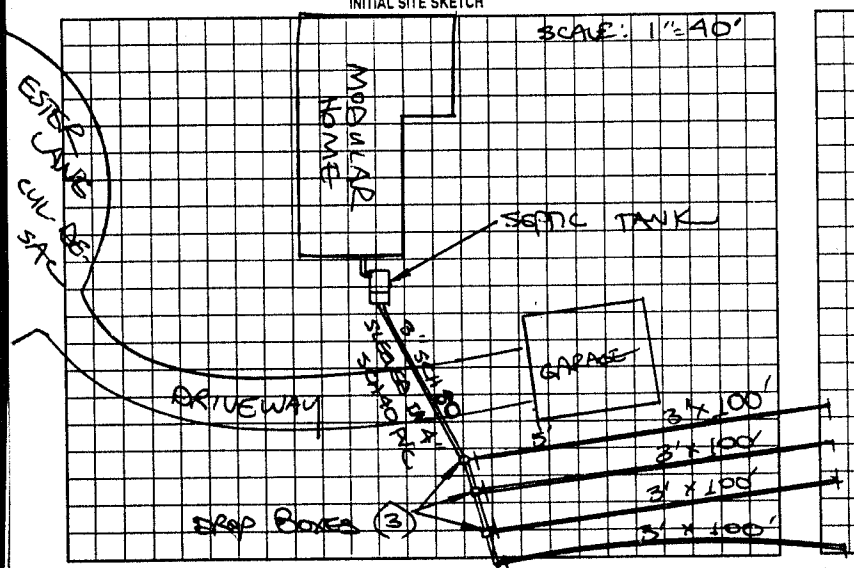

AS BUILT SKETCH

SYSTEM INSTALLED ACCORDING TO INITIAL SITE SKETCH

Permit can be suspended or revoked if any false information is supplied toward securing the permit/any unauthorized changes are made to the site/any unauthorized changes are made in the installation of the system. Improvement Permit with plat valid without expiration. Improvement Permit with site plan valid for sixty months. Authorization to Construct is valid for a period equal to that of Improvement Permit – not to exceed sixty months.

Signed: Fil Fishner date 25 July 00

Improvement Permit by: STEVE HEDRICK date 7-24-00

Authorization to Construct by: STEVE HEDRICK date 7-24-00

Installed by: SAMMY REAVIS

Operation Permit by: STEVE HEDRICK date 8-14-00

Existing System Inspection by: date

HEALTH DEPT. COPY: WHITE OWNER COPY (FINAL): YELLOW OWNER COPY (INITIAL): PINK