IREDELL COUNTY HEALTH DEPARTMENT

Statesville Phone TR 3-7271 Mooresville Phone NO 3-1271

PERMIT TO INSTALL SEPTIC TANK

Permit NO._____ Permit Date_____ 195__

Owner Mt Bethel Church Address Mooresville

Installed By Roy F. Lentz Address Statesville


Location of Property_____

Tank		Capacity		Length of Lines		Fixtures	
Block	(4)	800	( )	150'	(4)	No. of Baths	( )
Precast	( )	900	(4)	175'	( )	Dishwasher	( )
		1000	( )	200'	( )	Garbage Grdr.	( )
		1100	( )	225'	( )	Auto-Washer	( )
		1200	( )	250'	( )	Other_____	
		Other_____		Other_____			

NOTIFY HEALTH DEPARTMENT AT LEAST EIGHT HOURS BEFORE TANK IS TO BE INSPECTED.

Final Inspection Aug 1 1952 Approved ( ) Disapproved ( )

Remarks_____

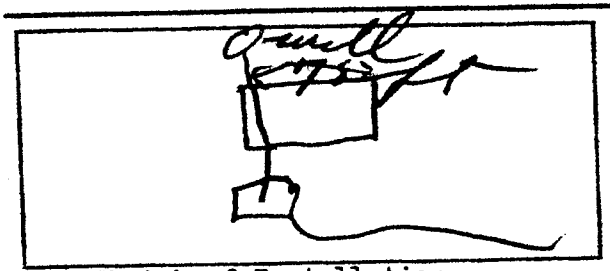

Sketch of Installation

Sanitarian