IREDELL COUNTY HEALTH DEPARTMENT

STATESVILLE 704-878-5305 MOORESVILLE 704-664-5281

IMPROVEMENT PERMIT / AUTHORIZATION TO CONSTRUCT / OPERATION PERMIT / EXISTING SYSTEM INSPECTION

PERMIT# REPAIR PIN# 4778 79 9902 DATE 6-29-01

OWNER OR CONTRACTOR JAMES R. McLAMB PHONE: Business (704) 838-1516 Home (704) 546-5322

ADDRESS 127 FLORA LANE, HARMONY, NC 28634

LOCATION US 21 NORTH, TR MT. BETHEL ROAD, ON LEFT AT BOX # 613 (JUST BEFORE FOUR ANDREWS DR)

SUBDIVISION ____ BLOCK / SECTION ____ LOT ____ LOT AREA ____ SITE CLASS PS DESIGN FLOW 240 L.T.A.R. EXISTING

Septic Tank: 1000 Gallons: STB 760 Date 5-5-01
Pump Tank: ____ Gallons: PT ____ Date ____
Pump Make: ____ Model ____ Serial No ____
Nitrification Field: No Fields 1 Square Feet 720 Linear Feet 240
No Lines THREE Trench Width 36" Max Trench Bottom Depth 36" Gravel Depth 12"

☐ New System ☑ Repair System Type: I (II) III. IV. V. VI
System Description: ____
Repair System Description: CONVENTIONAL GRAVITY
Maintenance Agreement Required: ☐ Yes ☑ No


☑ House/Mod. Home ☐ Mobile Home ☐ Business ☐ Other
No. Bedrooms 2 No. Bathrooms 1 1/2 No. Employees ____
☐ Slab ☑ Crawl Space ☐ Basement w/plumbing ☐ Basement wo/plumbing

Water Supply: ☐ Individual ☑ Public ☐ Community

Comments/Conditions: DETERMINE WHICH END OF EXISTING SEPTIC TANK IS OUTLET, REPLACE SANITARY TEE & USE 3" x 18' SCH 40 PVC TO SERIES OF NEW DROP BOXES FEEDING THREE LINES OF 80' EACH.

Comments/Conditions: SEPTIC TANK WITH MARKER INSTALLED USING "ZABEL" FILTER

INITIAL SITE SKETCH

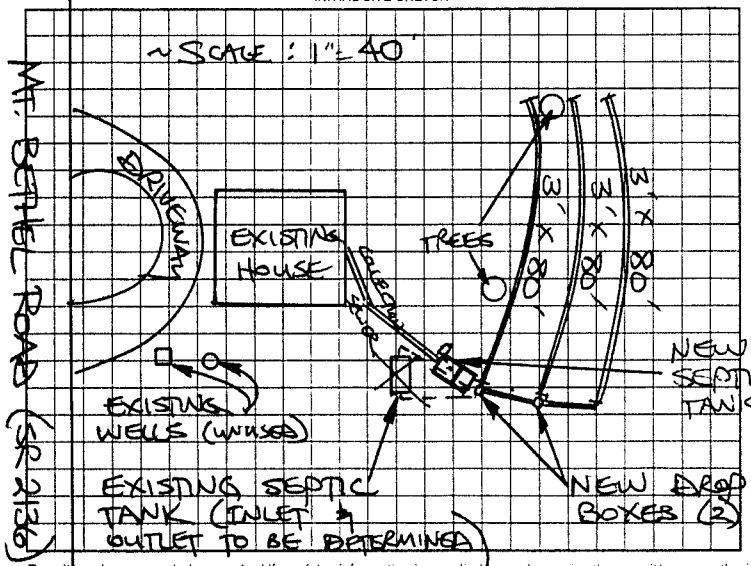

AS BUILT SKETCH

SYSTEM REPAIRED ACCORDING TO INITAL SITE SKETCH

Permit can be suspended or revoked if any false information is supplied toward securing the permit/any unauthorized changes are made to the site/any unauthorized changes are made in the installation of the system. Improvement Permit with plat valid without expiration. Improvement Permit with site plan valid for sixty months. Authorization to Construct is valid for a period equal to that of Improvement Permit – not to exceed sixty months.

Signed: James R. McLamb date 7-09-01 Installed by: BARRY SIGMON

Improvement Permit by: STEVE HEDRICK date 6-29-01 Operation Permit by: STEVE HEDRICK date 8-16-01

Authorization to Construct by: STEVE HEDRICK date 6-29-01 Existing System Inspection by: ____ date ____

HEALTH DEPT. COPY: WHITE OWNER COPY (FINAL): YELLOW OWNER COPY (INITIAL): PINK