IREDELL COUNTY HEALTH DEPARTMENT

STATESVILLE 704-878-5305 MOORESVILLE 704-664-5281

IMPROVEMENT PERMIT / AUTHORIZATION TO CONSTRUCT / OPERATION PERMIT / EXISTING SYSTEM INSPECTION

400

PERMIT# 070560 PIN# 4779 72 2240

OWNER OR CONTRACTOR RON McLAMB DATE 2-6-98

ADDRESS c/o P.O. BOX 1651, STATESVILLE, NC 28687 PHONE: Business 872-0227 Home

LOCATION US 21 N, TR MT. BETHEL RD, TR FLORA LANE, 2ND LOT ON LEFT

SUBDIVISION Mt. Bethel Est. BLOCK / SECTION LOT 5 LOT AREA 2.153 Acres SITE CLASS. PS DESIGN FLOW 360 L.T.A.R. 0.30 GPD/FT2

Septic Tank: 1000 Gallons; STB 1007 Date 3-18-98

Pump Tank: Gallons; PT Date

Pump Make: Model Serial No.

Nitrification Field: No Fields 1 Square Feet 1200 Linear Feet 400

No Lines FOUR Trench Width 36" Max Trench Bottom Depth 36" Gravel Depth 12"

☑ New System ☐ Repair System Type: ☐ I, ☑ II, III, IV, V, VI

System Description: CONVENTIONAL GRAVITY

Repair System Description: CONV. GRAVITY/PUMP

Maintenance Agreement Required: ☐ Yes ☑ No

☑ House/Mod. Home ☐ Mobile Home ☐ Business ☐ Other

No. Bedrooms 3 No. Bathrooms 3 No. Employees

☐ Slab ☑ Crawl Space ☐ Basement w/plumbing ☑ Basement wo/plumbing

Water Supply: ☐ Individual ☑ Public ☐ Community


Comments:/Conditions:

THIS PERMIT VOIDS PREVIOUS ISSUED 1-21-98


Comments:/Conditions:

* 1st Drain line ~ 30ft from Tank
Tank is ~ 20ft from house

INITIAL SITE SKETCH SCALE: 1" = 60'

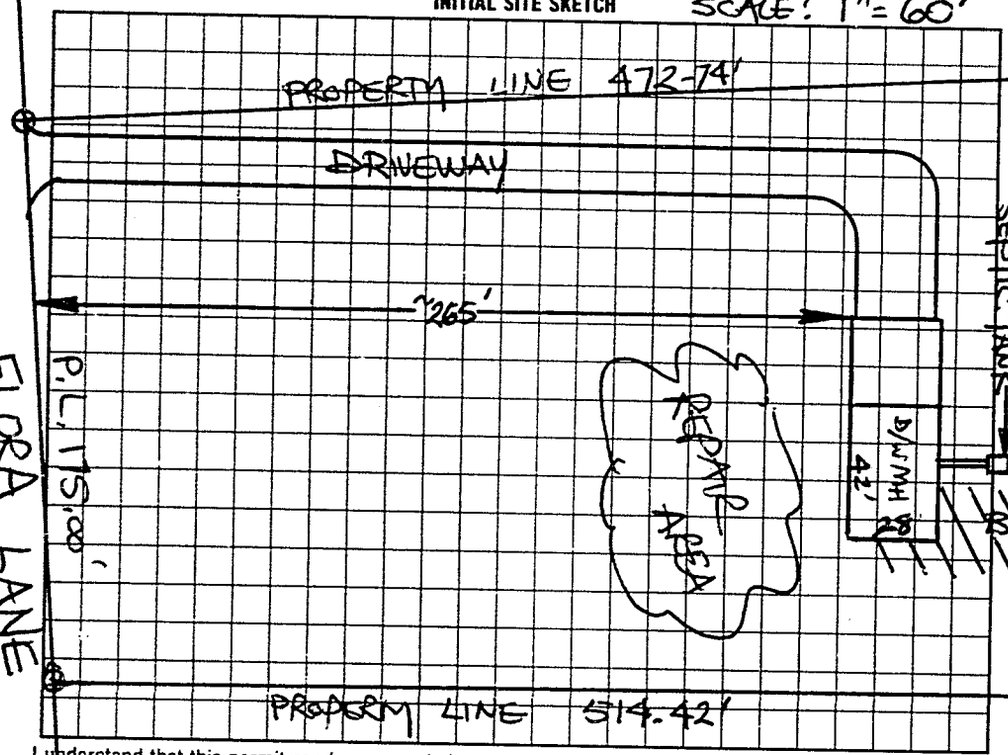

AS BUILT SKETCH

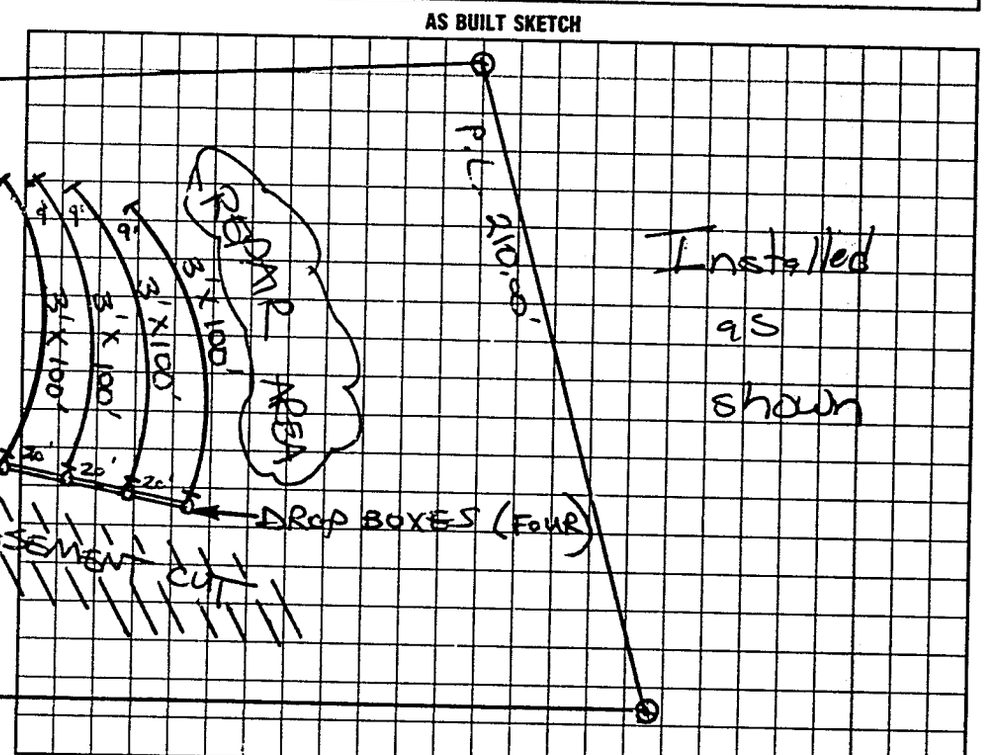

I understand that this permit can be suspended or revoked if any false information is supplied toward securing the permit/any unauthorized changes are made to the site/any unauthorized changes are made in the installation of the system. Improvement Permit with plat valid without expiration. Improvement Permit with site plan valid for sixty months. Authorization to Construct is valid for a period equal to that of Improvement Permit – not to exceed sixty months.

Signed: Jack C. Clanton date 2-11-98

Improvement Permit by: STEVE HENDRICK date 2-6-98

Authorization to Construct by: STEVE HENDRICK date 2-6-98

Installed by: James Huddler

Operation Permit by: Mark C Ortz RS date 4-28-98

Existing System Inspection by: date

HEALTH DEPT. COPY: WHITE INSPECTION COPY (FINAL): GREEN OWNER COPY (FINAL): YELLOW INSPECTION COPY (INITIAL): PINK OWNER COPY (INITIAL): GOLD