#0250 12-12-97

IREDELL COUNTY HEALTH DEPARTMENT

STATESVILLE 704-878-5305 MOORESVILLE 704-664-5281

IMPROVEMENT PERMIT / CERTIFICATE OF COMPLETION / OPERATION PERMIT / EXISTING SYSTEM INSPECTION

PROPERTY DESCRIPTION NO. 24397 070700 DATE 12-11-97 TAX MAP NO. 12H-4-A-2 Watershed: ☐ Yes ☐ No

OWNER OR CONTRACTOR Leonard Scarborough PHONE: Business Home 878 0064

ADDRESS 112 Flora Lane Harmony

LOCATION Alt Mocksville RJ Turn rt Bethel ch Rt past church To Flora 1st Home Rt.

SUBDIVISION Mt Bethel Estates BLOCK / SECTION LOT 2 LOT AREA 2.02 acres SITE CLASS. PS DESIGN FLOW 360 L.T.A.R. .3

Septic Tank: 1000 Gallons; STB 1012 Date 9-16-97

Pump Tank: Gallons; PT Date

Pump Make: Model Serial No.

Nitrification Field: No Fields 1 Square Feet 1200 Linear Feet 400

No Lines 4 Trench Width 36" Max Trench Bottom Depth 36" Gravel Depth 12"

☑ New System ☐ Repair System Type: I, II, III, IV, V, VI

System Description: Conv. Gravity

Repair System Description: " " / Pump Conv.

Maintenance Agreement Required: ☐ Yes ☐ No

☐ House/Mod. Home ☐ Mobile Home ☐ Business ☐ Other

No. Bedrooms 3 No. Bathrooms 2 No. Employees

☐ Slab ☐ Crawl Space ☐ Basement w/plumbing ☐ Basement wo/plumbing


Water Supply: ☐ Individual ☐ Community ☑ Public

Comments:


Replace Permit
Issued To Donna Eisenboss 7-28-96

Comments:

INITIAL SITE SKETCH

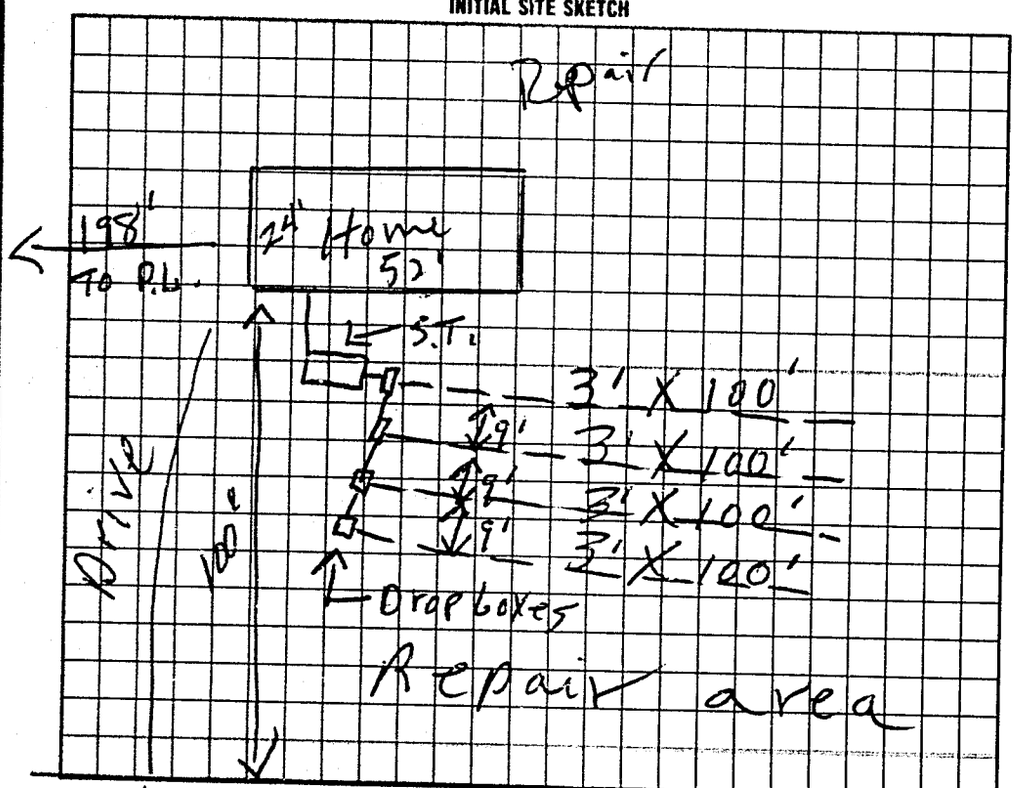

AS BUILT SKETCH

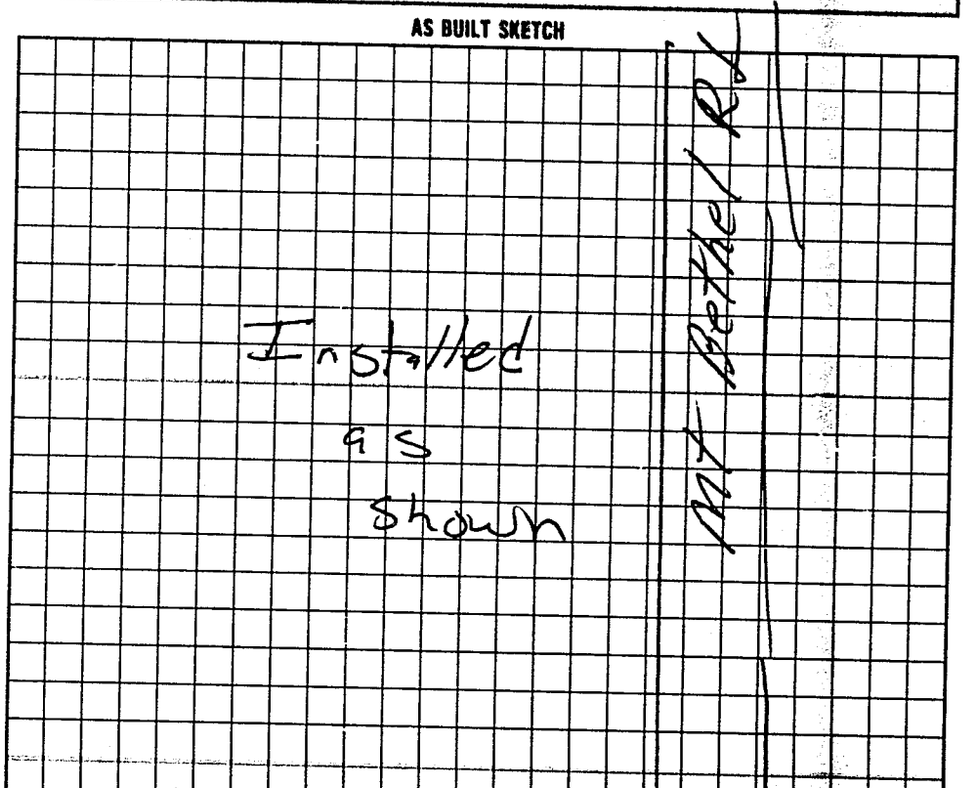

I understand that this permit can be suspended or revoked if any false information is supplied toward securing the permit/any unauthorized changes are made to the site/any unauthorized changes are made in the installation of the system. Improvement Permit is valid for 60 months from date of issuance.

Signed: Leonard Scarborough Flora Lane

Improvement Permit by: P.C. Moore date 12-11-97

Authorization to Existing System Inspection by: P.C. Moore date 12-11-97

to count

Installed by: A-1 Backhoe

Certificate of Completion by: date

Operation Permit by: Mark C. Outlaw RS date 1-5-98

HEALTH DEPT. COPY: WHITE INSPECTION COPY (FINAL): GREEN OWNER COPY (FINAL): YELLOW INSPECTION COPY (INITIAL): PINK OWNER COPY (INITIAL): GOLD

Authorization to count EXPIRES 6 mos from issue