IREDELL COUNTY HEALTH DEPARTMENT

THIS PERMIT VOIDS PREVIOUS ISSUED 10-20-99

STATESVILLE 704-878-5305 MOORESVILLE 704-664-5281

IMPROVEMENT PERMIT / AUTHORIZATION TO CONSTRUCT / OPERATION PERMIT / EXISTING SYSTEM INSPECTION

PERMIT# 08417 PIN# 4779 72 4769 DATE 11-18-99

OWNER OR CONTRACTOR TIMOTHY A. BROOKS PHONE: Business Home 585-2039

ADDRESS Rt. 1 Box 264 STONY POINT NC 28678

LOCATION US 21 N, T/R Mt. BETHEL ROAD, LOT ON RIGHT, ACCROSS FROM RIMROCK ROAD

SUBDIVISION Mt. BETHEL EST BLOCK / SECTION LOT 1 LOT AREA 2.00 ACRES SITE CLASS PS DESIGN FLOW 360 L.T.A.R. 0.30 GAD/FT²

Septic Tank: 1000 Gallons; STB 1012 Date 7-27-99
Pump Tank: Gallons; PT Date
Pump Make: Model Serial No.
Nitrification Field: No Fields 1 Square Feet 1200 Linear Feet 400
No Lines FIVE Trench Width 36" Max Trench Bottom Depth 36" Gravel Depth 12"

☒ New System ☐ Repair System Type: I (II) III IV V VI
System Description: CONVENTIONAL GRAVITY
Repair System Description: CONVENTIONAL PUMP
Maintenance Agreement Required: ☐ Yes ☒ No
☐ Slab ☒ Crawl Space ☐ Basement w/plumbing ☐ Basement wo/plumbing


☐ House/Mod. Home No. Bedrooms 3
☒ Mobile Home No. Bathrooms 2
☐ Business No. Employees
☐ Other

Water Supply: ~~Individual~~ ☒ Public ☐ Community ~~WELL~~


Comments:/Conditions: ~~KEEP SYSTEM MINIMUM 100 FEET FROM WELL~~

Comments:/Conditions: ① SEPTIC TANK W/ RISERS INSTALLED USING "POLYLOK" FILTER ② SYSTEM LEFT OPEN DURING PERIOD OF WET WEATHER

INITIAL SITE SKETCH SCALE: 1"=60'

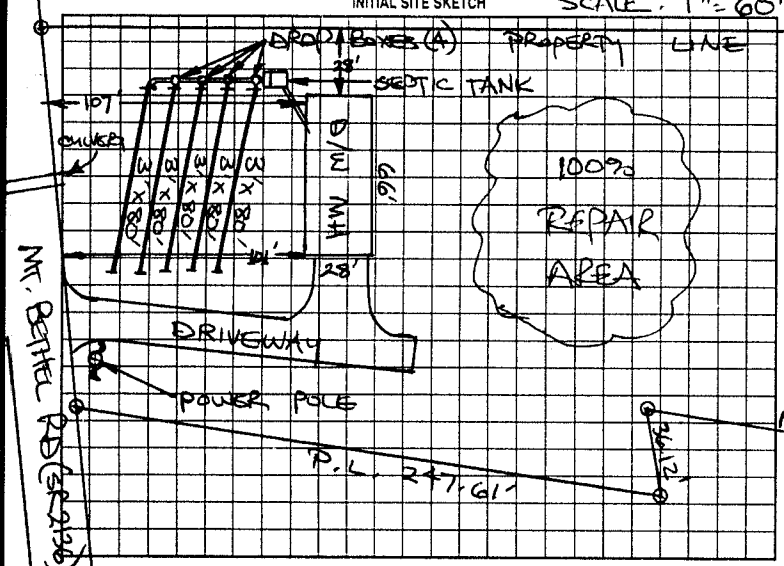

AS BUILT SKETCH

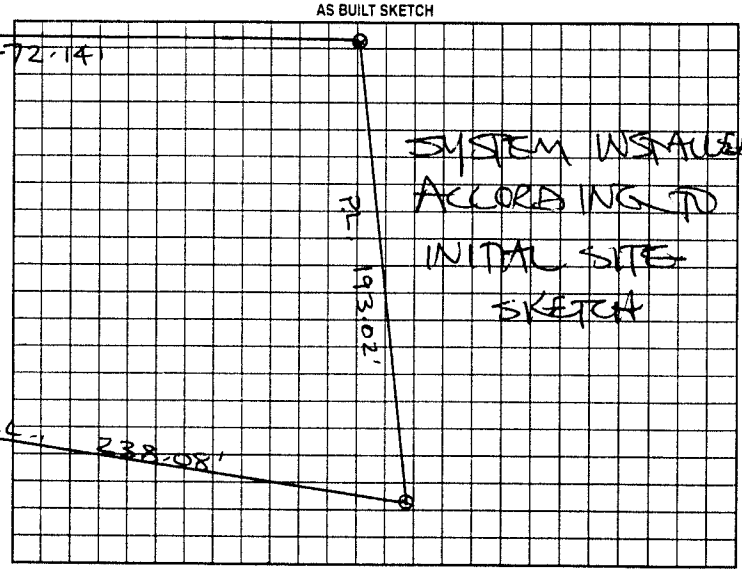

Permit can be suspended or revoked if any false information is supplied toward securing the permit/any unauthorized changes are made to the site/any unauthorized changes are made in the installation of the system. Improvement Permit with plat valid without expiration. Improvement Permit with site plan valid for sixty months. Authorization to Construct is valid for a period equal to that of Improvement Permit – not to exceed sixty months.

Signed: Tim Brooks by: [illegible] date 11-18-99 Installed by: C & W GRADING

Improvement Permit by: STEVE HEDRICK date 11-18-99 Operation Permit by: STEVE HEDRICK date 12-13-99

Authorization to Construct by: STEVE HEDRICK date 11-18-99 Existing System Inspection by: date

HEALTH DEPT. COPY WHITE OWNER COPY (FINAL): YELLOW OWNER COPY (INITIAL): PINK