IREDELL COUNTY HEALTH DEPARTMENT

STATESVILLE 704-878-5305 MOORESVILLE 704-664-5281

IMPROVEMENT PERMIT / CERTIFICATE OF COMPLETION / OPERATION PERMIT / EXISTING SYSTEM INSPECTION

PROPERTY DESCRIPTION NO. 070623 DATE 12-8-97 TAX MAP NO. 4779 12 9397

OWNER OR CONTRACTOR JEFFREY NICHOLS PHONE: Business Watershed: ☐ Yes ☑ No

ADDRESS 499 MT. BETHEL ROAD, HARMONY NC 28634 Home 546-7237

LOCATION US 21 N, TR MT. BETHEL RD, 1ST DRIVE ON PAST RIMROCK ROAD ON LEFT

SUBDIVISION BLOCK / SECTION LOT LOT AREA 2.0 ACRES SITE CLASS. PS DESIGN FLOW 480 L.T.A.R. 0.4 GPD/FT² (EXIST)

Septic Tank: 1000 Gallons; STB Date

Pump Tank: Gallons; PT Date

Pump Make: Model Serial No.

Nitrification Field: No Fields 1 Square Feet 300 Linear Feet 100

No Lines 1 Trench Width 36" Max Trench Bottom Depth 36" Gravel Depth 12"

☑ New System ☐ Repair System Type: I, II, III, IV, V, VI

System Description: CONVENTIONAL GRAVITY

Repair System Description: CONV. GRAVITY

Maintenance Agreement Required: ☐ Yes ☑ No

☐ House/Mod. Home ☑ Mobile Home ☐ Business ☐ Other

No. Bedrooms 4 No. Bathrooms 2 No. Employees


☐ Slab ☑ Crawl Space ☐ Basement w/plumbing ☐ Basement wo/plumbing

Water Supply: ☑ Individual ☐ Community ☐ Public

Comments: SYSTEM TO BE EXPANDED TO ACCOMMODATE 4 BR MH.

Comments:

INITIAL SITE SKETCH SCALE: 1"=40'

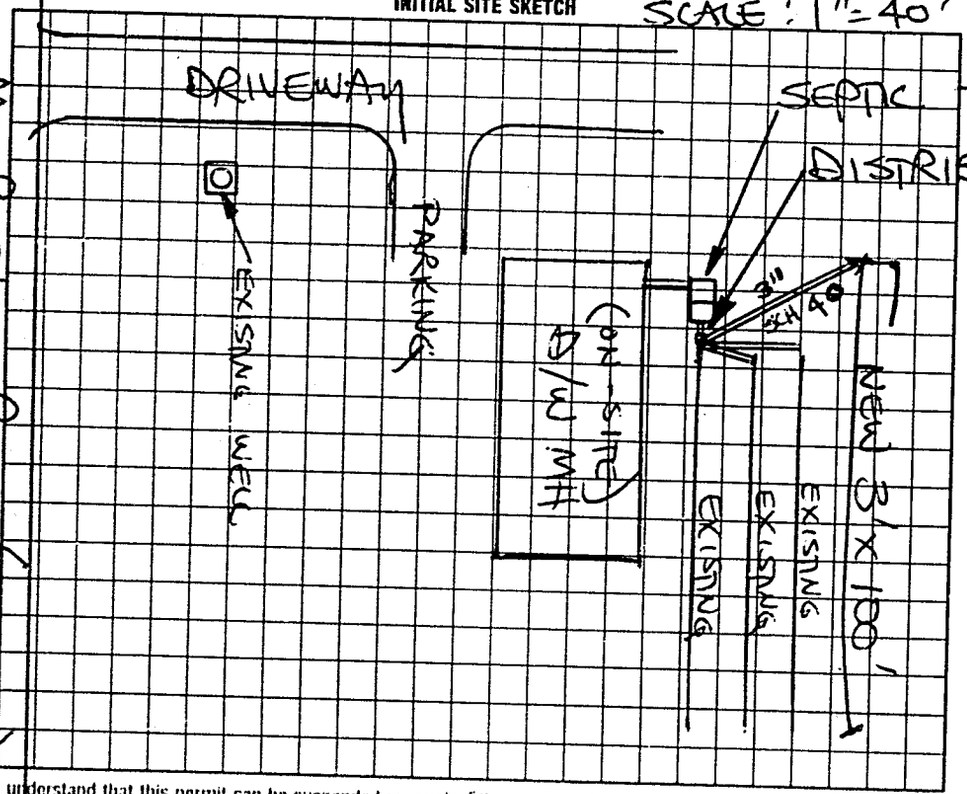

AS BUILT SKETCH

Installed

I understand that this permit can be suspended or revoked if any false information is supplied toward securing the permit/any unauthorized changes are made to the site/any unauthorized changes are made in the installation of the system. Improvement Permit is valid for 60 months from date of issuance. AUTHORIZATION TO CONSTRUCT IS VALID FOR 60 MONTHS FROM DATE OF ISSUE.

Signed: X Jennie Nichols

Improvement Permit by: STEVE HODRICK date 12-9-97

AUTH. TO CONST.

~~Existing System Inspection~~ by: STEVE HODRICK date 12-9-97

Installed by: J C Forsyth

~~Certificate of Completion~~ by: date

Operation Permit by: Mary C Ortz RS date 12-22-98

HEALTH DEPT. COPY: WHITE INSPECTION COPY (FINAL): GREEN OWNER COPY (FINAL): YELLOW INSPECTION COPY (INITIAL): PINK OWNER COPY (INITIAL): GOLD