2-30-300

IREDELL COUNTY HEALTH DEPARTMENT

STATESVILLE 704-878-5305 (ad) MOORESVILLE 704-664-5281 (ad)

IMPROVEMENT PERMIT / AUTHORIZATION TO CONSTRUCT / OPERATION PERMIT / EXISTING SYSTEM INSPECTION

PERMIT# 151600 PIN# 4779729577 DATE 7-17-08

OWNER OR APPLICANT Clayton Homes Carolina Land LLC PHONE: Business 704-873-2547 Home

ADDRESS 2052 Northside Drive Statesville NC 28677

LOCATION Int Bethel 2nd lot pas Kimpack

SUBDIVISION Saddle gate BLOCK / SECTION LOT 12 LOT AREA 1.29 SITE CLASS B5 DESIGN FLOW 360 L.T.A.R. .3

Septic Tank: 1000 Gallons: STB 760 Date 7-19-09

Pump Tank: Gallons: PT Date

Pump Make: Model Serial No.

Nitrification Field: No Fields Square Feet 600 Linear Feet 300

No Lines 4 Trench Width 36" Max Trench Bottom Depth 36" Gravel Depth

☑ New System ☐ Repair ☐ Expansion System Type: I II III IV V VI

System Description: 2540 Gravity

Repair System Description: 2540 Gravity

Maintenance Agreement Required: ☐ Yes ☑ No

☑ Gravity ☐ Pressure

☑ House/Mod. Home ☐ Mobile Home ☐ Business ☐ Other

No. Bedrooms 3 No. Persons No. Employees

Water Supply: ☑ Individual ☐ Public ☐ Community


☐ Slab ☐ Crawl Space ☐ Basement w/plumbing ☐ Basement wo/plumbing

Comments:/Conditions:


Comments:/Conditions:

Maintain all setbacks
Install on contour

INITIAL SITE SKETCH

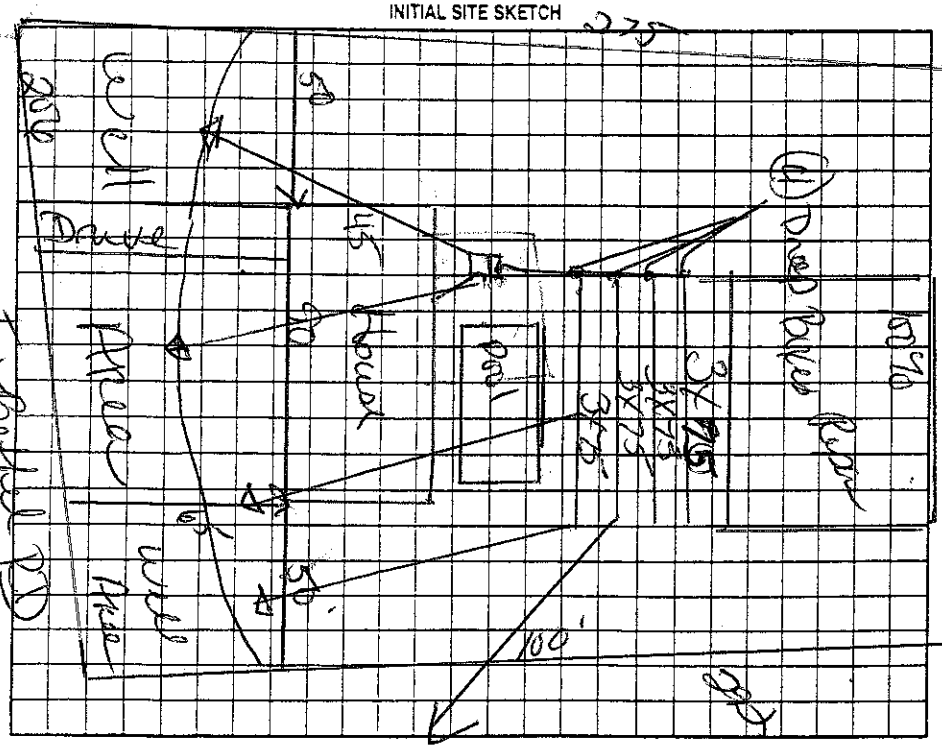

AS BUILT SKETCH

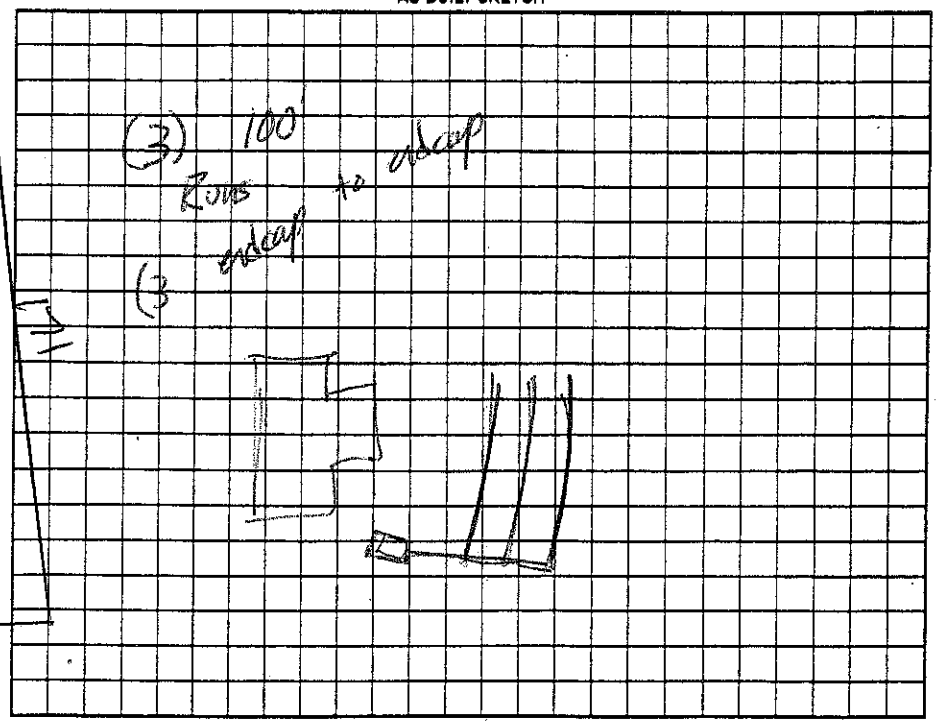

Permit can be suspended or revoked if any false information is supplied toward securing the permit/any unauthorized changes are made to the site/any unauthorized changes are made in the installation of the system. Improvement Permit with plat valid without expiration ☐ Improvement Permit with site plan valid for sixty months ☑ Authorization to Construct is valid for a period equal to that of Improvement Permit – not to exceed sixty months.

Signed: Deena A Price date 7-17-08 Installed by: Akre Grading

Improvement Permit by: Kelly Cox date 7-17-08 Operation Permit by: date 4-1-10

Authorization to Construct by: Kelly Cox date 7-17-08 Existing System Inspection by: date

HEALTH DEPT. COPY: WHITE OWNER COPY (FINAL): YELLOW OWNER COPY (INITIAL): PINK