IREDELL COUNTY HEALTH DEPARTMENT

STATESVILLE 704-878-5305 MOORESVILLE 704-664-5281

IMPROVEMENT PERMIT / CERTIFICATE OF COMPLETION / OPERATION PERMIT / EXISTING SYSTEM INSPECTION

PROPERTY DESCRIPTION NO. 19615 DATE 10/21/94 TAX MAP NO 12J- A-39 Watershed: ☐ Yes ☒ No

OWNER OR CONTRACTOR CLYDE ECCKLES EST. PHONE: Business Home 546-7527

ADDRESS RT-1, Box 241 HARMONY, NC 28634

LOCATION US 21 N, TR BETHEL RD, LAST MH ON RIGHT BEFORE RIMROCK ROAD

SUBDIVISION BLOCK / SECTION LOT LOT AREA 9 ACRES SITE CLASS BS DESIGN FLOW 240 L.T.A.R. EXISTING

Septic Tank: 1000 Gallons; STB Date

Pump Tank: Gallons; PT Date

Pump Make: Model Serial No.

Nitrification Field: No Fields Square Feet Linear Feet EXISTING

No Lines Trench Width Max Trench Bottom Depth Gravel Depth

☐ New System ☐ Repair System Type: I, II, III, IV, V, VI

System Description: CONVENTIONAL GRAVITY

Repair System Description: CONV. GRAVITY

Maintenance Agreement Required: ☐ Yes ☐ No

☐ Slab ☒ Crawl Space ☐ Basement w/plumbing ☐ Basement wo/plumbing

☐ House/Mod. Home No. Bedrooms 3

☒ Mobile Home No. Bathrooms 1

☐ Business No. Employees

☐ Other


Water Supply:
☐ Individual
☐ Community
☐ Public
WELL

Comments:

Comments: MH ON SITE AT TIME OF INSPECTION

INITIAL SITE SKETCH

AS BUILT SKETCH

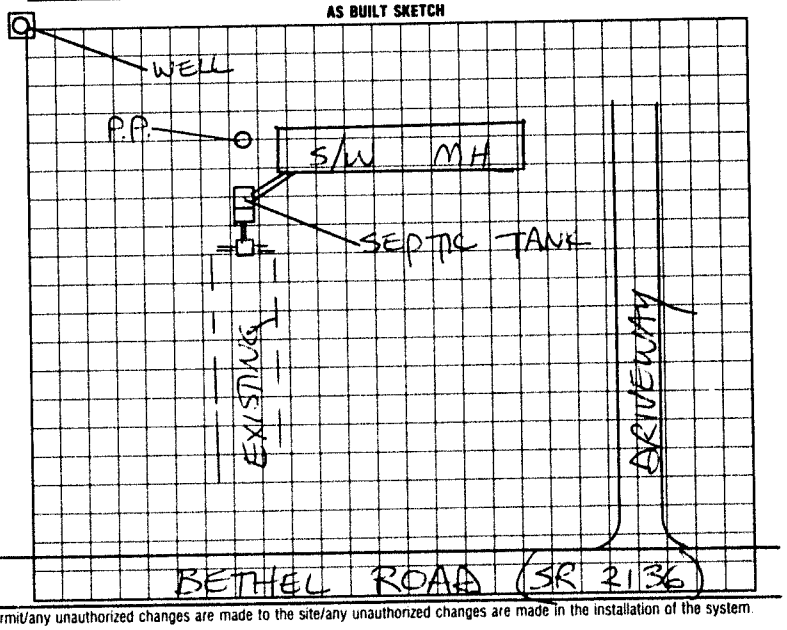

I understand that this permit can be suspended or revoked if any false information is supplied toward securing the permit/any unauthorized changes are made to the site/any unauthorized changes are made in the installation of the system. Improvement Permit is valid for 60 months from date of issuance.

Signed:

Improvement Permit by: date

Existing System Inspection by: STEVE HENDRICK date 10/21/94

Installed by:

Certificate of Completion by: date

Operation Permit by: date

HEALTH DEPT. COPY: WHITE INSPECTION COPY (FINAL): GREEN OWNER COPY (FINAL) YELLOW INSPECTION COPY (INITIAL) PINK OWNER COPY (INITIAL): GOLD