IREDELL COUNTY HEALTH DEPARTMENT

Statesville Phone TR 3-7271 Mooresville Phone NO 3-1271

PERMIT TO INSTALL SEPTIC TANK

Permit No. 251 Permit Date July 29 1970

Owner LAWRENCE ECKLES Address Rt. HARMONY N.C.

Installed By Adams Septic Tank Service Address TAYLORSVILLE, N.C.


Location of Property HIGHWAY 21 NORTH. to Log Cabin Service Sta. Turn RIGHT ON Road # 2136. 1½ MILES on R.

Tank		Capacity		Length of Lines		Fixtures	
Block	(✓)	1000	(✓)	225'	(✓)	No. of Baths	(✓)
Precast	( )	1250	( )	250'	( )	Dishwasher	( )
		1500	( )	Other		Garbage Grdr.	( )
		Other				Other	

NOTIFY HEALTH DEPARTMENT AT LEAST EIGHT HOURS BEFORE TANK IS TO BE INSPECTED.

Final Inspection July 29 1970 Approved (✓) Disapproved ( )

Remarks

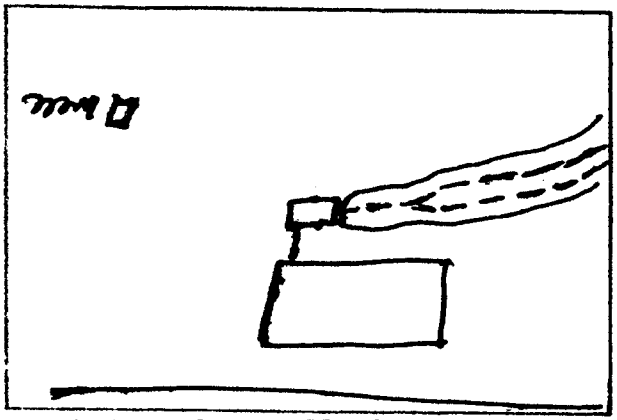

Sketch of Installation

Sanitarian