IREDELL COUNTY HEALTH DEPARTMENT

STATESVILLE 704-878-5305 MOORESVILLE 704-664-5281

IMPROVEMENT PERMIT / AUTHORIZATION TO CONSTRUCT / OPERATION PERMIT / EXISTING SYSTEM INSPECTION

(1)

PERMIT# 105069 PIN# 4779-74-2673 DATE 3-5-02

OWNER OR CONTRACTOR [redacted] HAROLD JAMES PHONE: Business Home 704-546-2295

ADDRESS 392 MT. BETHEL ROAD HARMONY NC 28634

LOCATION US 21 N, TR MT. BETHEL ROAD, 1.1 MILES ON RIGHT

SUBDIVISION BLOCK / SECTION LOT LOT AREA 1.15 ACRES SITE CLASS. PS DESIGN FLOW 360 L.T.A.R. 0.30 GPD/FT²

Septic Tank: 1000 Gallons; STB 760 Date 12-10-02

Pump Tank: Gallons; PT Date

Pump Make: Model Serial No.

Nitrification Field: No. Fields 1 Square Feet 1200 Linear Feet 400

No. Lines FOUR Trench Width 36" Max Trench Bottom Depth 36" Gravel Depth 12"

☑ New System ☐ Repair System Type: I (II) III IV V VI

System Description: CONVENTIONAL GRAVITY

Repair System Description: CONVENTIONAL, PUMP

Maintenance Agreement Required: ☐ Yes ☑ No

☐ House/Mod. Home ☑ Mobile Home ☐ Business ☐ Other

No. Bedrooms 3 No. Bathrooms 2 No. Employees


☐ Slab ☑ Crawl Space ☐ Basement w/plumbing ☐ Basement wo/plumbing

Water Supply: ☐ Individual ☑ Public ☐ Community

Comments/Conditions: ADDITIONAL REPAIR

Comments/Conditions: ① SEPTIC TANK WITH MARKER INSTALLED USING 4" ZABEL" FILTER ② SYSTEM INSTALLED DURING PERIOD OF WET SOIL CONDITIONS

INITIAL SITE SKETCH

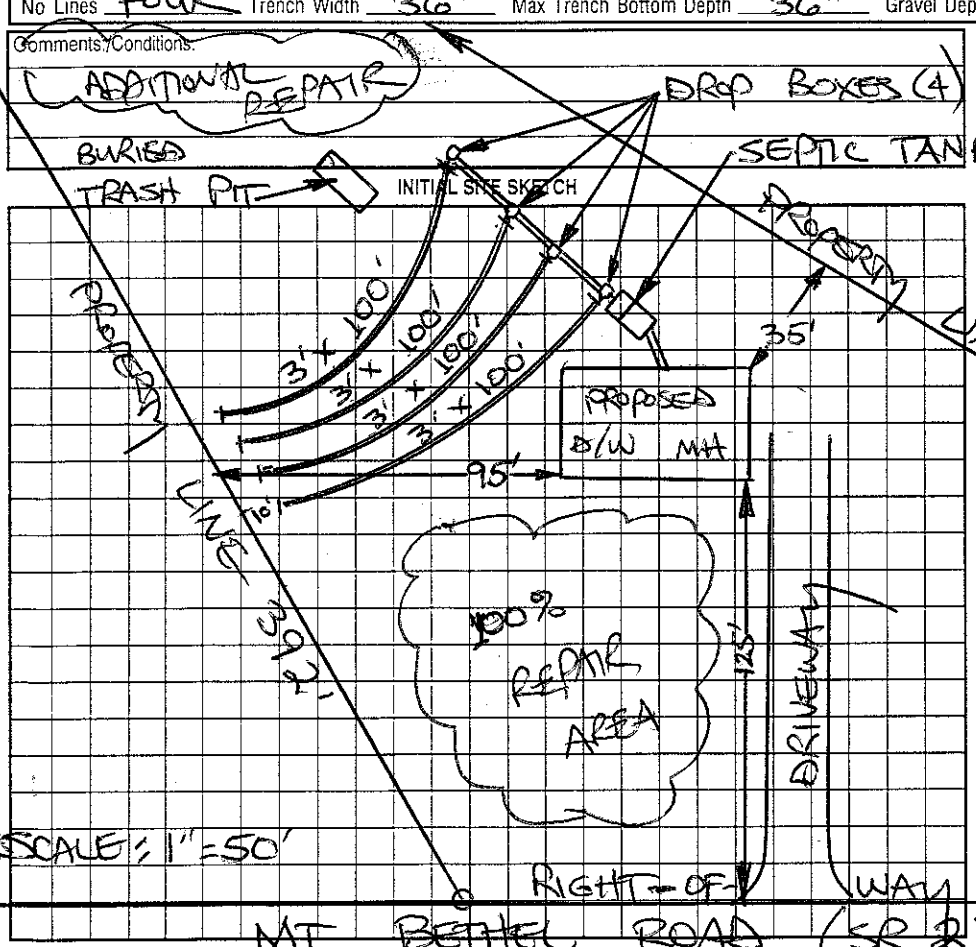

AS BUILT SKETCH

SYSTEM INSTALLED ACCORDING TO INITAL SITE SKETCH

Permit can be suspended or revoked if any false information is supplied toward securing the permit/any unauthorized changes are made to the site/any unauthorized changes are made in the installation of the system. Improvement Permit with plat valid without expiration. Improvement Permit with site plan valid for sixty months. Authorization to Construct is valid for a period equal to that of Improvement Permit – not to exceed sixty months.

Signed: +Harold James date 3-5-02 Installed by: SHERMAN DUNN

Improvement Permit by: STEVE HEDRICK date 3-5-02 Operation Permit by: STEVE HEDRICK date 4-22-03

Authorization to Construct by: STEVE HEDRICK date 3-5-02 Existing System Inspection by: date

HEALTH DEPT. COPY: WHITE OWNER COPY (FINAL): YELLOW OWNER COPY (INITIAL): PINK