IREDELL COUNTY HEALTH DEPARTMENT

Statesville Office (704) 878-5305 Mooresville Office (704) 660-3625

IMPROVEMENT PERMIT / AUTHORIZATION TO CONSTRUCT / OPERATION PERMIT / EXISTING SYSTEM

PERMIT # 17907

APPLICANT: Elliot Gaither

PIN # 4779841457

SITE ADDRESS: 397 Mt. Bethel Rd.

APPLICANT ADDRESS: 1143 Tabor Rd.

SITE DIRECTIONS: Hwy 21N TR Mt. Bethel Rd ~ 1mile on left

PHONE: 704-929-1208 ALT. PHONE: N/A

SUBDIVISION: N/A

SECTION: N/A LOT # N/A LOT AREA: 1.0 acres DESIGN FLOW: 360gpd L.T.A.R.: 0.25

Septic Tank	1000 (gal)	STB	760-1000	Date	3-2		
Pump Tank	(gal)	PT		Date			
Pump Make		Model		Serial #			
# Nitrification Fields	1	# Lines	3	Linear Ft:	360		
Trench Width	36"	Max. Trench Bottom Depth	36"	Gravel Depth	N/A		

☑ New System ☐ Repair ☐ Expansion System Type: I II III IV V VI

System Description: 25% Reduction

Repair System Description: 25% Reduction

Maintenance Agreement Required: ☐ YES ☑ NO

☑ GRAVITY ☐ PRESSURE


☑ Residence ☐ Business ☐ Other ☐ Slab ☐ Basement w/plumbing

No. Bedrooms 3 No. Persons 6 No. Employees ☑ Crawl Space

Water Supply: ☐ Private ☑ Public ☐ Community ☐ Basement w/o plumbing

Comments / Conditions: Improvements ONLY! Properly abandon well prior to issuance of CA. Obtain well abandonment permit from heath department. Install a 25% Reduction system on contour with serial distribution.

INITIAL SITE SKETCH

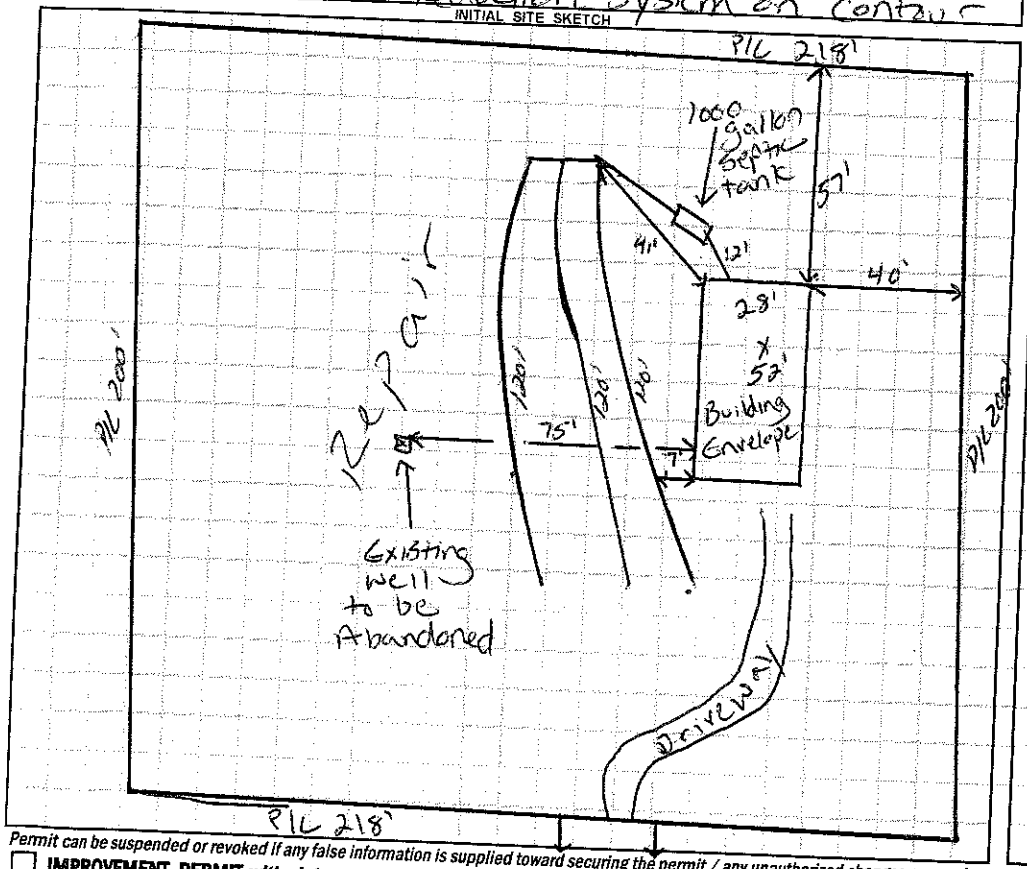

AS BUILT SKETCH

Scale 1"=50'

- Red Polylok filter installed
- Quick 4 Chambers installed
- Installed as drawn

Permit can be suspended or revoked if any false information is supplied toward securing the permit / any unauthorized changes are made to the site / any unauthorized changes are made in the installation of the system. **CONTACT A LOCATOR SERVICE PRIOR TO ANY EXCAVATION**

☐ **IMPROVEMENT PERMIT** *with plat valid without expiration.* ☑ **IMPROVEMENT PERMIT** *with site plan valid for 60 mos.* ☐ **AUTHORIZATION TO CONSTRUCT** *valid for period equal to IMPROVEMENT PERMIT--not to exceed 60 mo.*

Owner / Applicant Signature:

IMPROVEMENT PERMIT by: Justin Henderson Date: 7-15-13

AUTHORIZATION TO CONSTRUCT by: Justin Henderson Date: 7-2-13

Installed by: Gunter Grading

OPERATION PERMIT by: Justin Henderson Date: 5-5-14

Existing System Inspected by: Date: 6-12-14

Health Dept. Copy - WHITE Applicant (Final Approval) - YELLOW Applicant (Conditional Approval) - PINK