IREDELL COUNTY HEALTH DEPARTMENT

STATESVILLE 704-878-5305 MOORESVILLE 704-664-5281

IMPROVEMENT PERMIT / CERTIFICATE OF COMPLETION / OPERATION PERMIT / EXISTING SYSTEM INSPECTION

PROPERTY DESCRIPTION NO. 17146 DATE 10/11/93 TAX MAP NO. 12H-A-142

OWNER OR CONTRACTOR FREDERICK DALTON PHONE: Business Home 546-2463

ADDRESS Rt-1, Box 242, HARMONY NC 28634

LOCATION US 21 N, TR BETHEL RD, BEHIND SID (H) ON (L) EAST SHAW ROAD

SUBDIVISION BLOCK / SECTION LOT LOT AREA SITE CLASS PS L.T.A.R. EXISTING

Water Supply: ✓ Individual ☐ Community ☐ Public WELL NEXT DOOR

Septic Tank: EXISTING Gallons: STB Date

Pump Tank: Gallons: PT Date

Nitrification Field: No Fields Square Feet Linear Feet EXISTING

No Lines 3 Trench Width Trench Depth Gravel Depth 12"

☐ New System ☐ Repair System Type: (I) II, III, IV, V, VI

System Description: CONV. GRAVITY

Repair System Description:

Maintenance Agreement Required: ☐ Yes ✓ No

House/Mod. Home No. Bedrooms 3

Mobile Home No. Bathrooms 2

Business No. Employees

Other

Slab ~~Crawl Space~~ Basement w/plumbing Basement wo/plumbing

Garbage Disposal: ☐ Yes ~~No~~

Auto. Dishwasher: ~~Yes~~ ☐ No


Auto. Washing Machine: ✓ Yes ☐ No

Other

Comments KEEP MH MINIMUM 5' FROM SEPTIC SYSTEM

INITIAL SITE SKETCH

AS BUILT SKETCH

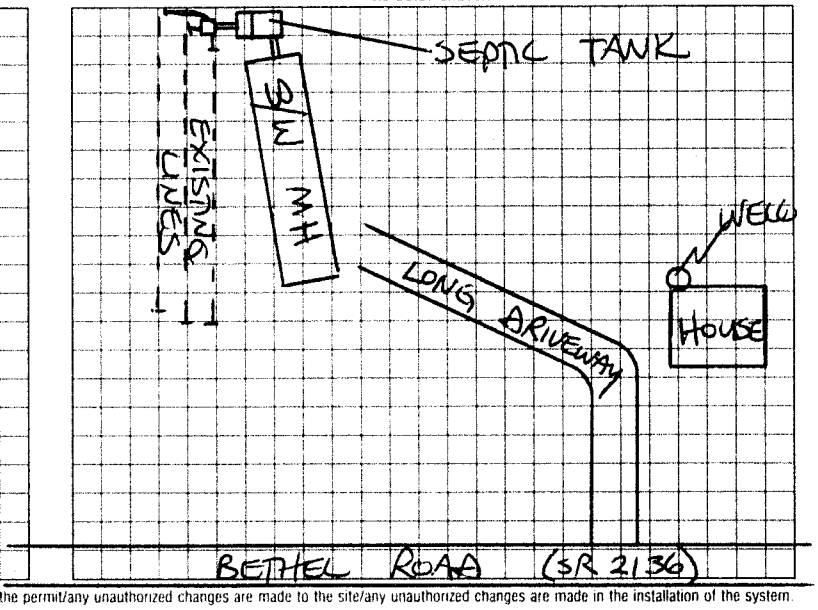

I understand that this permit can be suspended or revoked if any false information is supplied toward securing the permit/any unauthorized changes are made to the site/any unauthorized changes are made in the installation of the system. Improvement Permit is valid for 60 months from date of issuance.

Signed:

Improvement Permit by: date

Existing System Inspection by: STEVE HEARICK date 10/11/93

Installed by

Certificate of Completion by date

Operation Permit by date

HEALTH DEPT. COPY: WHITE INSPECTION COPY (FINAL) GREEN OWNER COPY (FINAL) YELLOW INSPECTION COPY (INITIAL) PINK OWNER COPY (INITIAL) GOLD