4779815659

IREDELL COUNTY HEALTH DEPARTMENT

STATESVILLE 704-878-5305 MOORESVILLE 704-664-5281

IMPROVEMENT PERMIT / AUTHORIZATION TO CONSTRUCT / OPERATION PERMIT / EXISTING SYSTEM INSPECTION

PERMIT # 174451 PIN # 4779814867 DATE 12-6-12

OWNER or APPLICANT David Burney (Am. Home Place) PHONE: Business 704-746-7094 Home: N/A

OWNER or APPLICANT ADDRESS 229 Linkside Court Lenoir

LOCATION / DIRECTIONS I-77 N exit 54 TR 21N TR Mt. Bethel TL Kimrock TR Shine

SUBDIVISION Saddlegate BLOCK / SECTION N/A LOT # 7,8,13 LOT AREA 28.55 acres DESIGN FLOW 360 gpd L.T.A.R. 0.3

Septic Tank 1000 Gallons: STB 1000 Date 6-27-12
Pump Tank 1000 Gallons: PT 17-1000 Date 4-1-11
Pump Make Gould's Model PES1M 0.5HP Serial # A1349290
Nitrification Field No Fields 1 No Lines 2 Linear Feet 300
Trench Width 36" Max. Trench Bottom Depth 36" Gravel Depth N/A

☑ New System ☐ Repair ☐ Expansion System Type I II III IV V VI
System Description: Pump - 25% Reduction
Repair System Description: Pump - 25% Reduction
Maintenance Agreement Required ☐ YES ☑ NO
☐ GRAVITY ☑ PRESSURE


☑ Residence No. Bedrooms 3
☐ Business No. Persons
☐ Other No. Employees
☐ Slab ☑ Crawl Space
☐ Basement w/plumbing ☐ Basement w/o plumbing

Water Supply: ☑ Private ☐ Public ☐ Community

Comments / Conditions: Install a 25% Reduction system on contour with parallel distribution as shown below. Use 1½" Sch 40 force main.

Comments / Conditions

INITIAL SITE SKETCH

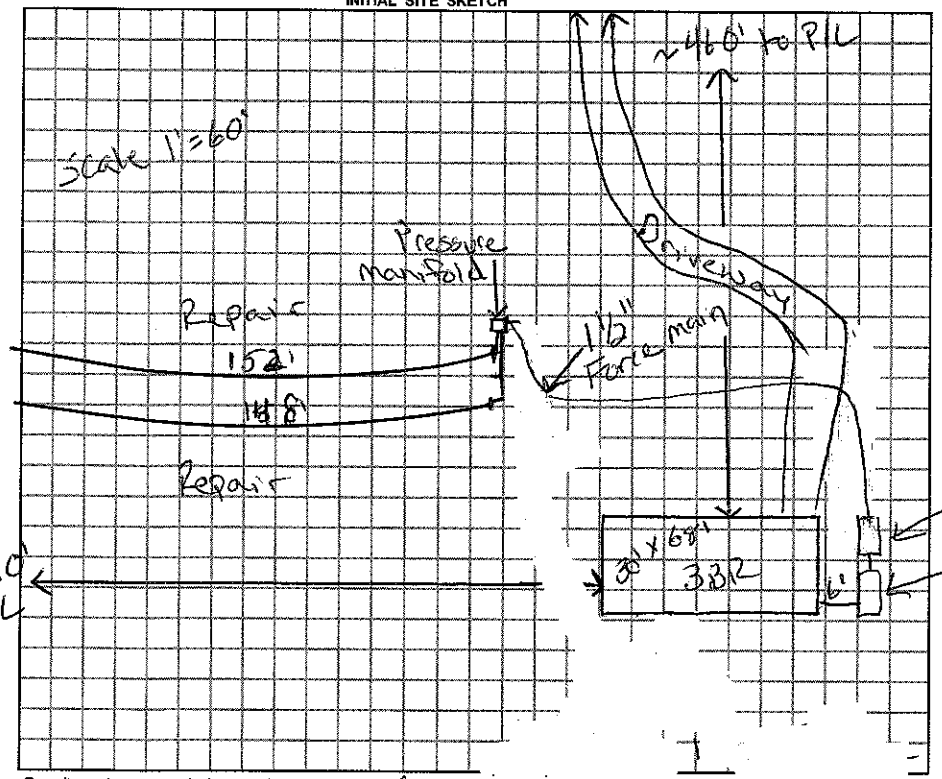

AS BUILT SKETCH

- 2" Septic tank meter installed
- 25% Reduction Quick4 Chambers installed
- Red Poly for fill installed 30" deep
- Force main installed under driveway 18" deep
- Fiber installed over pump compartment 13" above grade
- Installed as drawn

Permit can be suspended or revoked if any false information is supplied toward securing the permit / any unauthorized changes are made to the site / any unauthorized changes are made in the installation of the system.

☐ *IMPROVEMENT PERMIT w / plat valid without expiration.* ☑ *IMPROVEMENT PERMIT w / site plan valid for 60 mos.* ☑ *AUTHORIZATION TO CONSTRUCT valid for period equal to IMPROVEMENT PERMIT-not to exceed 60 mo.*

Owner / Applicant Signature: [signature] Date 12/10/12

Improvement Permit by: Justin Henderson Date 12-6-12

Authorization to Construct by: Justin Henderson Date 12-6-12

YOU SHOULD CONTACT A LOCATOR SERVICE PRIOR TO ANY EXCAVATION.

Installed by: Groundbreakers

Operation Permit by: Justin Henderson Date: 3-6-13

Existing System Inspected by: Date:

WHITE COPY Environmental Health YELLOW COPY (Final) Owner / Applicant PINK COPY (Initial) Owner / Applicant