IREDELL COUNTY HEALTH DEPARTMENT

STATESVILLE 704-878-5305 MOORESVILLE 704-664-5281

IMPROVEMENT PERMIT / CERTIFICATE OF COMPLETION / OPERATION PERMIT / EXISTING SYSTEM INSPECTION

PROPERTY DESCRIPTION NO. 23032 DATE 1-26-96 TAX MAP NO. 12H-A-123 Watershed Yes ✓ No

OWNER OR CONTRACTOR VIRGINIA BLANKENSHIP PHONE Business Home 546-2955

ADDRESS 363 SHAW ROAD, HARMONY, NC 28634

LOCATION US 21 N, TR BETHEL RD, TL SHAW ROAD, N 0.5 MILE ON (R), 2ND MH

SUBDIVISION BLOCK / SECTION LOT 2 LOT AREA LIMITED SITE CLASS / PS DESIGN FLOW 240 L T A R EXISTING

Septic Tank: 1000 Gallons; STB Date

Pump Tank: Gallons; PT Date

Pump Make: Model Serial No

Nitrification Field: No Fields 1 Square Feet 720 Linear Feet 240

No Lines 3 Trench Width 36" Max Trench Bottom Depth Gravel Depth 12"

New System Repair System Type CONV. GRAVITY

System Description

Repair System Description

Maintenance Agreement Required Yes NO

Slab ✓ Crawl Space Basement w/plumbing Basement w/o plumbing

House/Mod Home ✓ No Bedrooms 2

Mobile Home No Bathrooms 2

Business No Employees

Other 2BR ONLY


Water Supply: Individual / Community / Public

Comments:

Comments: ① KEEP MH MINIMUM 5' FROM SYSTEM ② SYSTEM APPEARS TO BE UNDERSIZED ACCORDING TO TODAY'S STANDARDS.

INITIAL SITE SKETCH

AS BUILT SKETCH

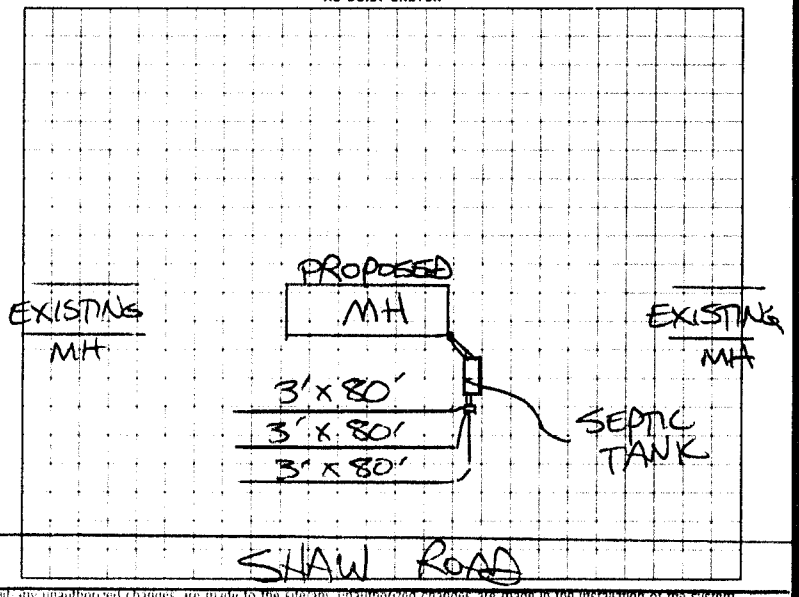

I understand that this permit can be suspended or revoked if any false information is supplied toward securing the permit any unauthorized changes are made to the site any unauthorized changes are made in the installation of the system

Signed:

Improvement Permit by: date

Existing System Inspection by STEVE HENDRICK date 1-26-96

Installed by

Certificate of Completion by date

Operation Permit by date

HEALTH DEPT COPY WHITE INSPECTION COPY (FINAL) GREEN OWNER COPY (FINAL) YELLOW INSPECTION COPY (INITIAL) PINK OWNER COPY (INITIAL) GOLD