IREDELL COUNTY HEALTH DEPARTMENT

STATESVILLE 704-878-5305 MOORESVILLE 704-664-5281

IMPROVEMENT PERMIT / AUTHORIZATION TO CONSTRUCT / OPERATION PERMIT / EXISTING SYSTEM INSPECTION

PERMIT# 102800 PIN# 4779-83-6301 DATE 10-22-01

~~OWNER~~ OR CONTRACTOR OAKWOOD HOMES PHONE: Business 704-528-4516 Home

ADDRESS 1042 CHARLOTTE HWY TROUTMAN, NC 28166

LOCATION US21N, TR Mt. BETHEL RD, TL RIMROCK RD, TR STONE RD, 1ST MH ON RIGHT AT #188

SUBDIVISION BLOCK / SECTION LOT LOT AREA 65 ACRES SITE CLASS PS DESIGN FLOW 360 L.T.A.R. 0.30 GPD/FT²

Septic Tank: EXISTING Gallons; STB Date

Pump Tank: Gallons; PT Date

Pump Make: Model Serial No.

Nitrification Field: No Fields 1 Square Feet 600 Linear Feet 200

No Lines TWO Trench Width 36" Max Trench Bottom Depth 36" Gravel Depth 12"

☑ New System ☐ Repair System Type: I II III IV V VI

System Description: CONVENTIONAL GRAVITY

Repair System Description: CONV, PUMP-FED

Maintenance Agreement Required: ☐ Yes ☑ No

☐ House/Mod. Home No. Bedrooms 3

☑ Mobile Home No. Bathrooms 2

☐ Business No. Employees

☐ Other


☐ Slab ☑ Crawl Space ☐ Basement w/plumbing ☐ Basement wo/plumbing

Water Supply: ☑ Individual ☐ Public ☐ Community WELL


Comments/Conditions: RESET DISTRIBUTION BOX AS SHALLOW AS POSSIBLE TO ACCOMMODATE TRENCH DEPTHS OF 36" OR LESS.

Comments/Conditions: SYSTEM EXPANDED OUT OF CONTOUR WITHOUT PRIOR HEALTH DEPARTMENT APPROVAL, AS SHOWN, STEPDOWN INSTALLED AS REMEDY

INITIAL SITE SKETCH

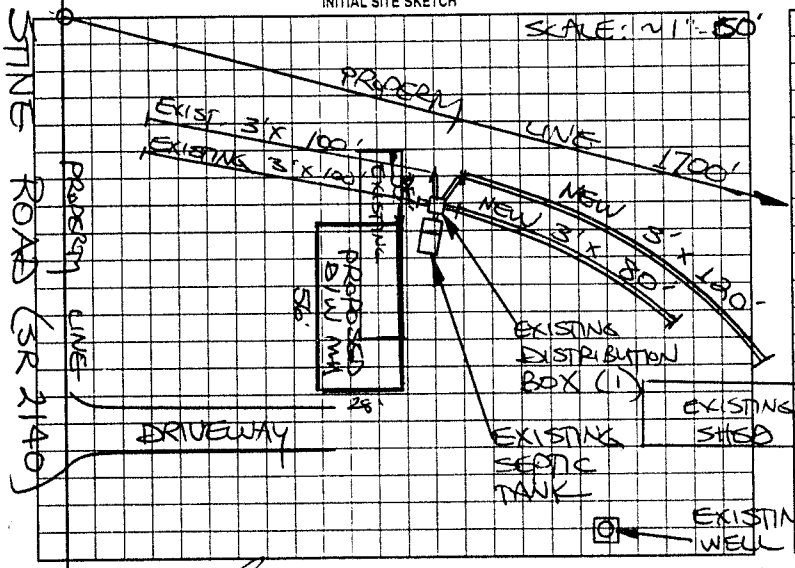

AS BUILT SKETCH

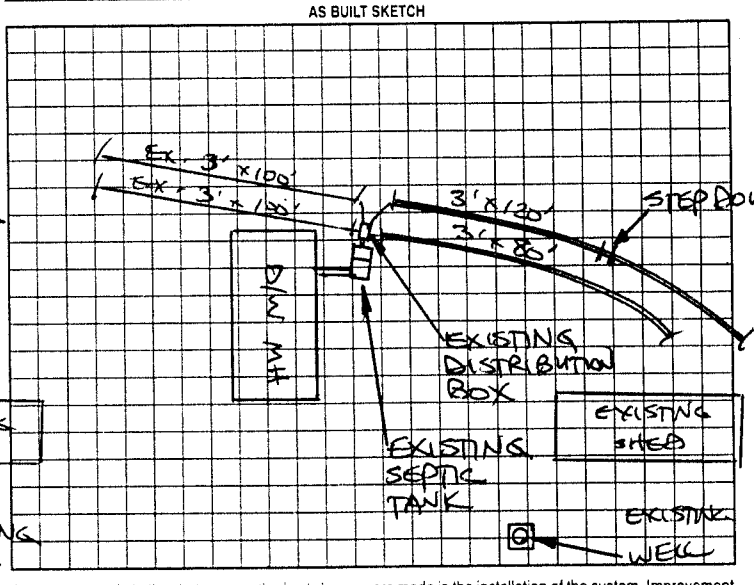

Permit can be suspended or revoked if any false information is supplied toward securing the permit/any unauthorized changes are made to the site/any unauthorized changes are made in the installation of the system. Improvement Permit with plat valid without expiration. Improvement Permit with site plan valid for sixty months. Authorization to Construct is valid for a period equal to that of Improvement Permit – not to exceed sixty months.

Signed: [signature] date 10-22-01 Installed by: CRAIG THOMPSON

Improvement Permit by: STEVE HEDRICK date 10-22-01 Operation Permit by: STEVE HEDRICK date 11-07-01

Authorization to Construct by: STEVE HEDRICK date 10-22-01 Existing System Inspection by: date

HEALTH DEPT. COPY: WHITE OWNER COPY (FINAL): YELLOW OWNER COPY (INITIAL): PINK