IREDELL COUNTY HEALTH DEPARTMENT

Statesville Office (704) 878-5305 Mooresville Office (704) 660-3625

IMPROVEMENT PERMIT / AUTHORIZATION TO CONSTRUCT / OPERATION PERMIT / EXISTING SYSTEM

PERMIT # 179809 DRH

PIN # 4779915998

APPLICANT: Jerry Stiles APPLICANT ADDRESS: 188 Stine Rd.

SITE ADDRESS: 153 Stine Rd. PHONE: 704-880-1586 ALT. PHONE: N/A

SITE DIRECTIONS: Hwy 21 N TR Mt. Bethel Rd. TL Rimrock Rd. TR Stine Rd.

SUBDIVISION: Saddlegate SECTION: N/A LOT # 6 LOT AREA: 7.25 acres DESIGN FLOW: 360 gpd L.T.A.R.: 0.3

Septic Tank 1000 (gal) STB 1012-1000 Date 3-8-14

Pump Tank (gal) PT Date

Pump Make Model Serial #

Nitrification Fields 1 # Lines 3 Linear Ft: 300

Trench Width 36" Max. Trench Bottom Depth 36" Gravel Depth N/A

☑ New System ☐ Repair ☐ Expansion System Type: I II ☑ III IV V VI

System Description: 25% Reduction

Repair System Description: 25% Reduction

Maintenance Agreement Required: ☐ YES ☑ NO

☑ GRAVITY ☐ PRESSURE

☑ Residence No. Bedrooms 3

☐ Business No. Persons

☐ Other No. Employees


☑ Slab ☐ Crawl Space

☐ Basement w/plumbing ☐ Basement w/o plumbing


Water Supply: ☐ Private ☑ Public ☐ Community

Comments / Conditions: IMPROVEMENTS ONLY; Submit floor plan prior to issuance of CA. Install a 25% Reduction system on contour with serial distribution. Install drainfield with trench bottoms @ 36".

INITIAL SITE SKETCH

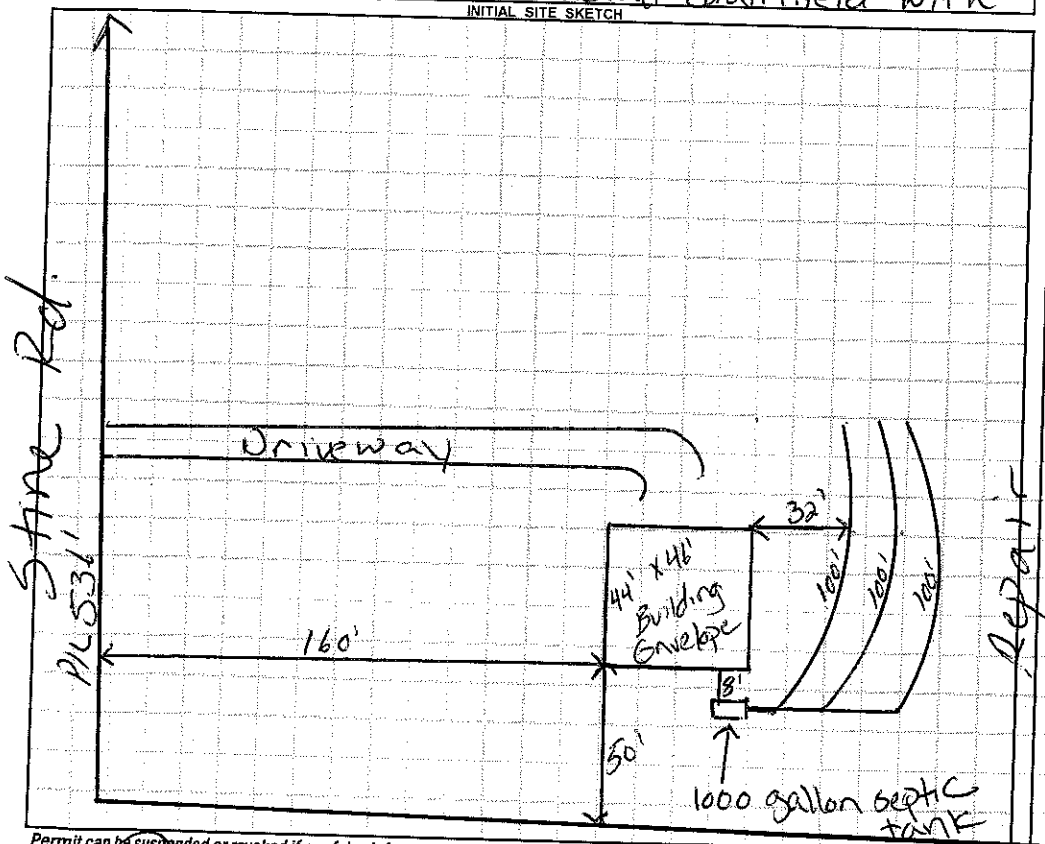

AS BUILT SKETCH

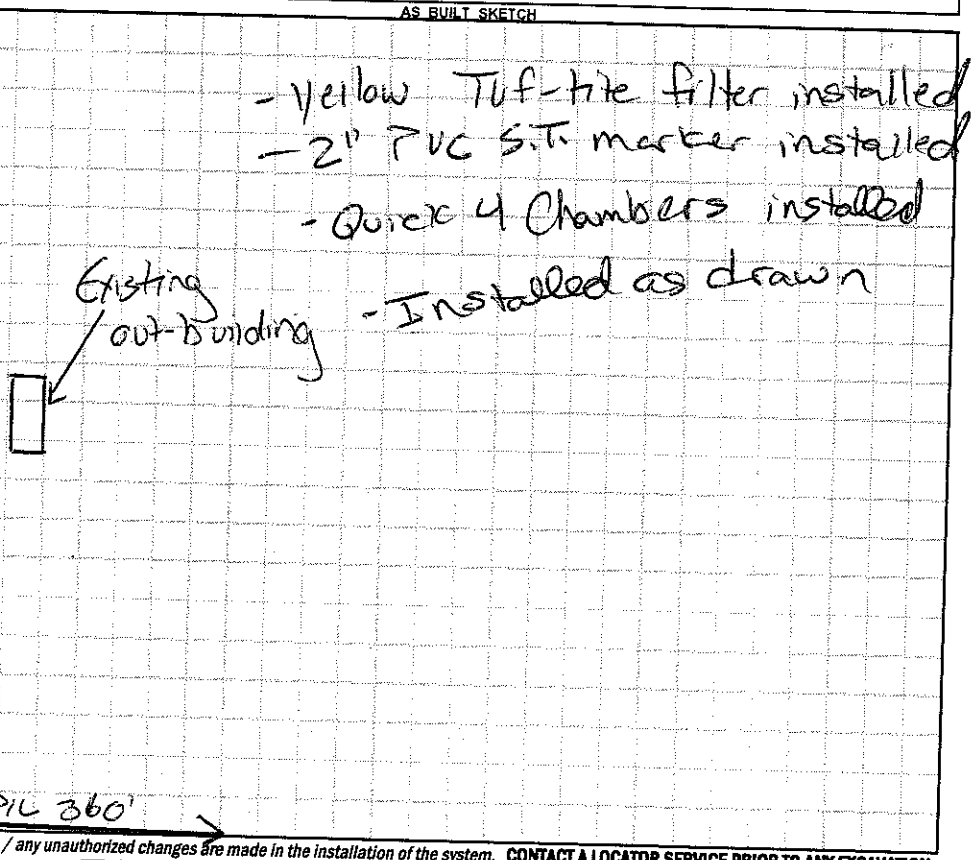

Permit can be suspended or revoked if any false information is supplied toward securing the permit / any unauthorized changes are made to the site / any unauthorized changes are made in the installation of the system. **CONTACT A LOCATOR SERVICE PRIOR TO ANY EXCAVATION**

☐ **IMPROVEMENT PERMIT** *with plat* valid without expiration. ☑ **IMPROVEMENT PERMIT** *with site plan* valid for 60 mos. ☑ **AUTHORIZATION TO CONSTRUCT** valid for period equal to IMPROVEMENT PERMIT--not to exceed 60 mo.

Owner / Applicant Signature: Jerry Stiles Date: 8-5-13 Installed by: Yountz Grading

IMPROVEMENT PERMIT by: Justin Henderson Date: 10-10-13 OPERATION PERMIT by: Justin Henderson Date: 5-6-14

AUTHORIZATION TO CONSTRUCT by: Justin Henderson Existing System Inspected by: Date:

Health Dept. Copy - WHITE Applicant (Final Approval) - YELLOW Applicant (Conditional Approval) - PINK