224

IREDELL COUNTY HEALTH DEPARTMENT

Statesville Phone TR 3-7271 Mooresville Phone NO 3-1271

PERMIT TO INSTALL SEPTIC TANK

Permit No. 76 by Pratt Elder. Permit Date June 18 1969

Owner Gilbert Cockels Address Hiway 21

Installed By C H Pratt Estate Address R 7


Location of Property 21 N - Right - before Log Cabin Sa. go 2 mile left before Church. go ¼ mile on left

Tank		Capacity		Length of Lines		Fixtures	
Block	( )	1000	( )	225'	( )	No. of Baths	( )
Precast	( )	1250	( )	250'	( )	Dishwasher	( )
		1500	( )	Other		Garbage Grdr.	( )
		Other				Other	

NOTIFY HEALTH DEPARTMENT AT LEAST EIGHT HOURS BEFORE TANK IS TO BE INSPECTED.

Final Inspection 19 Approved ( ) Disapproved ( )

Remarks well 75' not liable any grade damage or landscapework, as grading not done before Lab as regards Very deep - soil seems gen. owner & Elder O.K.d location as forced to cross prop line ~~approved~~ by Pond

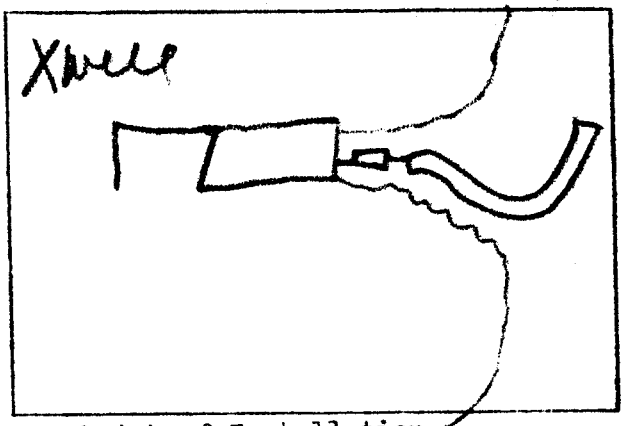

Sketch of Installation