IREDELL COUNTY HEALTH DEPARTMENT

STATESVILLE 704-878-5305 MOORESVILLE 704-664-5281

IMPROVEMENT PERMIT / AUTHORIZATION TO CONSTRUCT / OPERATION PERMIT / EXISTING SYSTEM INSPECTION

PERMIT# 15203 PIN# 4779930122 DATE 25 July 08

OWNER OR APPLICANT David Perry PHONE: Business 704-858-6907 Home

ADDRESS 322 York Spring Rd Hamptonville NC 27020

LOCATION 21N to NT Berke to Rembrock to arrow Rd 3rd on left

SUBDIVISION Duchess Ridge BLOCK / SECTION LOT 3 LOT AREA .46 SITE CLASS. PS DESIGN FLOW 360 L.T.A.R. .25

Septic Tank: 1000 Gallons: STB 102 Date 3-26-8

Pump Tank: Gallons: PT Date

Pump Make: Model Serial No.

Nitrification Field: No Fields Square Feet 1440 Linear Feet 360

No Lines 5 Trench Width 36" Max Trench Bottom Depth 36" Gravel Depth

☑ New System ☐ Repair ☐ Expansion System Type: I (II) IV V VI

System Description: 25% Graywater

Repair System Description: 50% Reduction

Maintenance Agreement Required: ☐ Yes ☑ No

☑ Gravity ☐ Pressure

☑ House/Mod. Home ☐ Mobile Home ☐ Business ☐ Other

No. Bedrooms No. Persons No. Employees

Water Supply: ☐ Individual ☐ Public ☐ Community

☐ Slab ☑ Crawl Space ☐ Basement w/plumbing ☐ Basement wo/plumbing


Comments:/Conditions:

Install on Contour
Maintain all setbacks

Comments:/Conditions:

Rake sidewalls
Red Surface tile

INITIAL SITE SKETCH (1"=40')

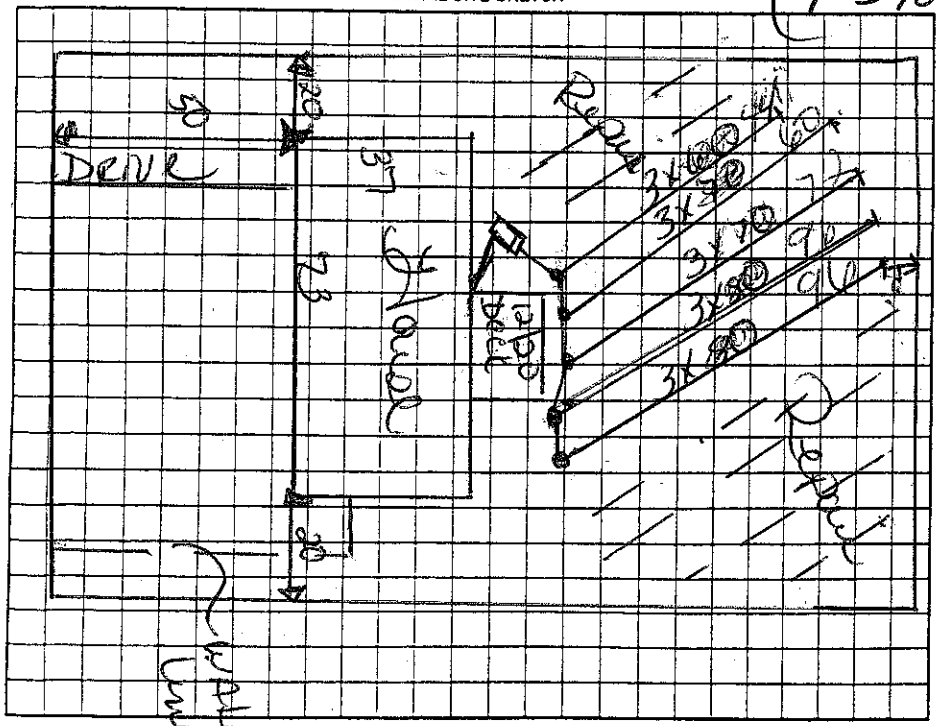

AS BUILT SKETCH

Septic Marker

Permit can be suspended or revoked if any false information is supplied toward securing the permit/any unauthorized changes are made to the site/any unauthorized changes are made in the installation of the system. Improvement Permit with plat valid without expiration ☐ Improvement Permit with site plan valid for sixty months ☑ Authorization to Construct is valid for a period equal to that of Improvement Permit – not to exceed sixty months.

Signed X David M Perry date 7-25-08

Improvement Permit by: Kelly Cook date 7-25-08

Authorization to Construct by: Kelly Cook date 7-25-08

Installed by: Tommy Frye

Operation Permit by: Kelly Cook date 2-23-09

Existing System Inspection by: date

HEALTH DEPT. COPY: WHITE OWNER COPY (FINAL): YELLOW OWNER COPY (INITIAL): PINK