Carol Moose

# IREDELL COUNTY HEALTH DEPARTMENT

STATESVILLE 704-878-5305 (ad) MOORESVILLE 704-664-5281

## IMPROVEMENT PERMIT / AUTHORIZATION TO CONSTRUCT / OPERATION PERMIT / EXISTING SYSTEM INSPECTION

PERMIT# 156471 PIN # 4779-93-6125 DATE

OWNER or APPLICANT Clayton Howe 2026 - Northside PHONE: Business Home: 704-873-2547

OWNER or APPLICANT ADDRESS 2026 Northside Dr. Statesville NC

LOCATION / DIRECTIONS 21N (R) Mt Bethel RD (L) Rimrock Lot on left in curve

SUBDIVISION BLOCK / SECTION LOT # LOT AREA 3.3 DESIGN FLOW 360 L.T.A.R. .25

Septic Tank 1000 Gallons: STB 760 Date 2-18-09

Pump Tank Gallons: P.T Date

Pump Make Model Serial #

Nitrification Field No Fields No Lines Linear Feet 360

Trench Width 36" Max. Trench Bottom Depth 36" Gravel Depth N/A

☑ New System ☐ Repair ☐ Expansion System Type I II (III) IV V VI

System Description: 2540 Gravity

Repair System Description: 504 Low Pr

Maintenance Agreement Required ☐ YES ☐ NO

☑ GRAVITY ☐ PRESSURE

☑ Residence No. Bedrooms 3

☐ Business No. Persons

☐ Other No. Employees

☐ Slab ☑ Crawl Space

☐ Basement w/plumbing ☐ Basement w/o plumbing

Water Supply: ☐ Private ☑ Public ☐ Community

Comments / Conditions


1st Septic line 10' off corner of house

Comments / Conditions


Install on contour

Maintain all setbacks

INITIAL SITE SKETCH

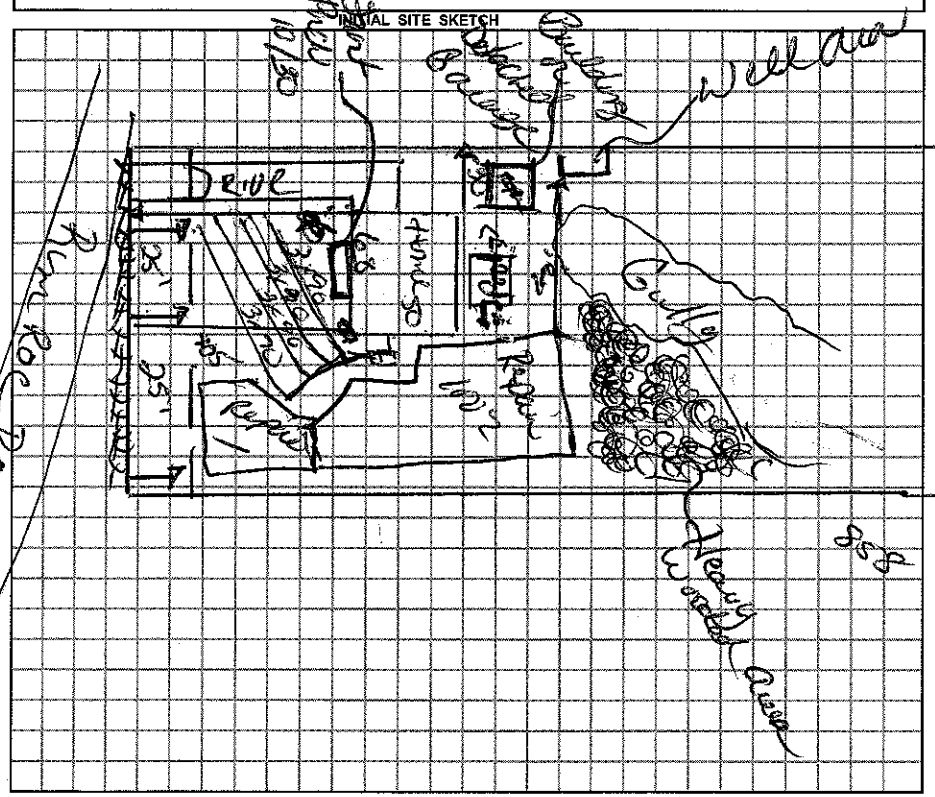


AS BUILT SKETCH

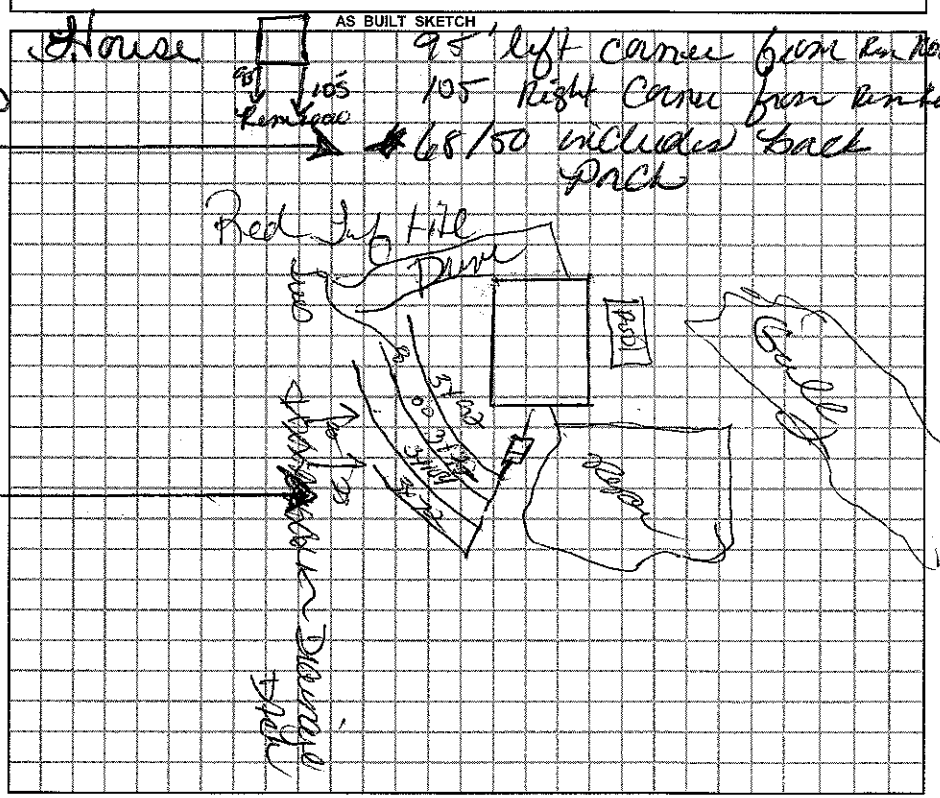


*Permit can be suspended or revoked if any false information is supplied toward securing the permit / any unauthorized changes are made to the site / any unauthorized changes are made in the installation of the system.*

☐ *IMPROVEMENT PERMIT w / plat valid without expiration* ☐ *IMPROVEMENT PERMIT w / site plan valid for 60 mos.* ☑ *AUTHORIZATION TO CONSTRUCT valid for period equal to IMPROVEMENT PERMIT-not to exceed 60 mo.*

Owner / Applicant Signature: Date 5-26-09

Improvement Permit by: Date 5-15-09

Authorzation to Construct by: Date 5-15-09

Installed by: Abey Grading

Operation Permit by: Date: 6-15-09

Existing System Inspected by: Date:

***YOU SHOULD CONTACT A LOCATOR SERVICE PRIOR TO ANY EXCAVATION.***

WHITE COPY Environmental Health YELLOW COPY (Final) Owner / Applicant PINK COPY (Initial) Owner / Applicant