IREDELL COUNTY HEALTH DEPARTMENT

STATESVILLE 704-878-5305 MOORESVILLE 704-664-5281

IMPROVEMENT PERMIT / AUTHORIZATION TO CONSTRUCT / OPERATION PERMIT / EXISTING SYSTEM INSPECTION

PERMIT # 161639 PIN # 4779-95-2243 DATE 2 July 10

OWNER or APPLICANT Richard Sappington / American Amphibian PHONE: Business (704) 872-4400 Home:

OWNER or APPLICANT ADDRESS 1206 Grassland Drive Statesville

LOCATION / DIRECTIONS I-77 21 N TR Mt. Bethel Rd. TL Shaw Rd TR Bunny Trail - 6th to END.

SUBDIVISION BLOCK / SECTION LOT # LOT AREA 4.24 ac. DESIGN FLOW 480 g/d L.T.A.R. 0.3/1.2 g/d

Septic Tank 1000 Gallons: STB Date

Pump Tank Gallons: P T Date

Pump Make Model Serial #

Nitrification Field No Fields 1 No Lines 4 Linear Feet 400

Trench Width 36" Max. Trench Bottom Depth 36" Gravel Depth NA

☑ New System ☐ Repair ☐ Expansion System Type I II III IV V VI

System Description: 25% Reduction

Repair System Description: 50% Reduction

Maintenance Agreement Required ☐ YES ☑ NO

☑ GRAVITY ☐ PRESSURE

☑ Residence No. Bedrooms 4

☐ Business No. Persons 4

☐ Other No. Employees

☐ Slab ☑ Crawl Space


☐ Basement w/plumbing ☐ Basement w/o plumbing

Water Supply: ☐ Private ☑ Public ☐ Community

Comments / Conditions: Existing house + barn to be demolished / Properly abandon old system before building new house /

Comments / Conditions

INITIAL SITE SKETCH

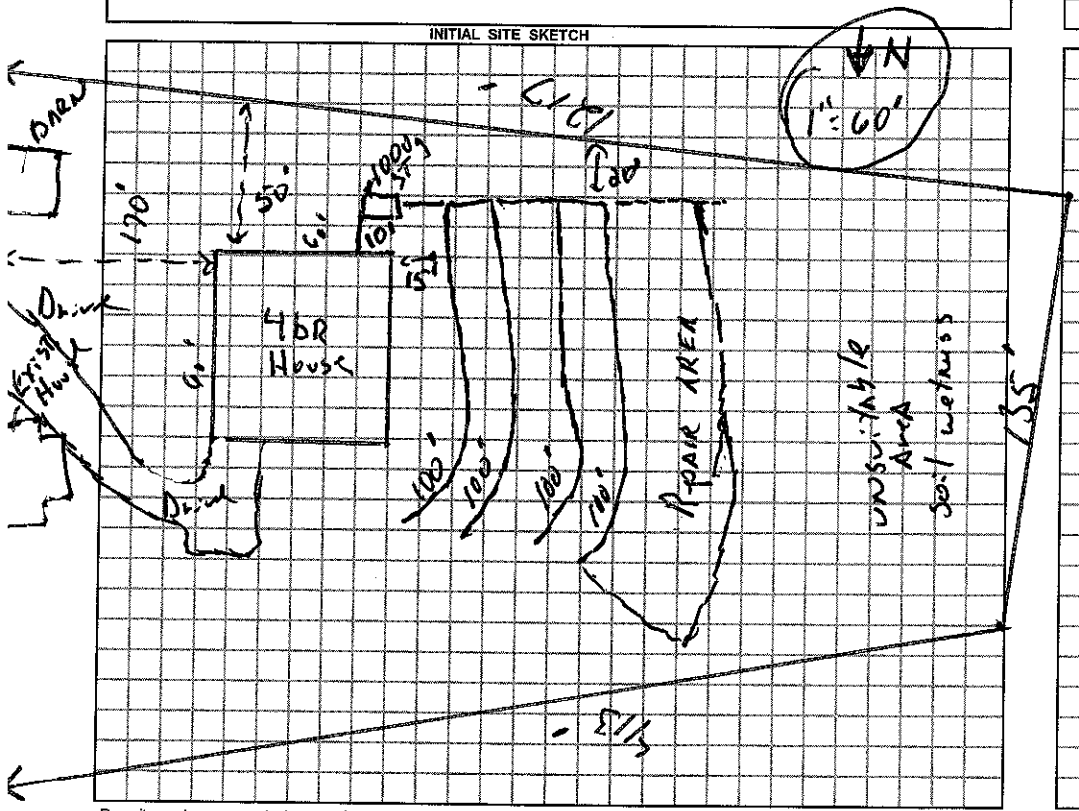

AS BUILT SKETCH

Installed as

3 x 120'

1 x 40'

otherwise same as drawn.

Permit can be suspended or revoked if any false information is supplied toward securing the permit / any unauthorized changes are made to the site / any unauthorized changes are made in the installation of the system.

☐ *IMPROVEMENT PERMIT w / plat valid without expiration.* ☑ *IMPROVEMENT PERMIT w / site plan valid for 60 mos.* ☑ *AUTHORIZATION TO CONSTRUCT valid for period equal to IMPROVEMENT PERMIT-not to exceed 60 mo.*

Owner / Applicant Signature: Date 7/8/10

Improvement Permit by: , R.S. Date 2 July 10

Authorzation to Construct by: , R.S. Date 2 July 10

Installed by: Jon McGee

Operation Permit by: , R.S. Date: 25 Aug 10

Existing System Inspected by: Date:

YOU SHOULD CONTACT A LOCATOR SERVICE PRIOR TO ANY EXCAVATION.

WHITE COPY Environmental Health YELLOW COPY (Final) Owner / Applicant PINK COPY (Initial) Owner / Applicant