IREDELL COUNTY HEALTH DEPARTMENT

STATESVILLE 704-878-5305 MOORESVILLE 704-664-5281

IMPROVEMENT PERMIT / AUTHORIZATION TO CONSTRUCT / OPERATION PERMIT / EXISTING SYSTEM INSPECTION

PERMIT # 15554 PIN # 4783 02 1283 DATE 3-26-09

OWNER or APPLICANT Alvin and Judy Cope PHONE: Business Home: 704-929-1080

OWNER or APPLICANT ADDRESS 3241 Salisbury Hwy Statesville 28625

LOCATION / DIRECTIONS 70 → Old 70 at end at left

SUBDIVISION BLOCK / SECTION LOT # LOT AREA 1.758 DESIGN FLOW 360 L.T.A.R. Exist

Septic Tank Exist Gallons: STB Exist Date Exist

Pump Tank Gallons: P T Date

Pump Make Model Serial #

Nitrification Field No Fields No Lines Linear Feet Exist

Trench Width Exist Max. Trench Bottom Depth Exist Gravel Depth Exist

~~Exist~~ ☐ New System ☐ Repair ☐ Expansion System Type I II IV V VI

System Description: Existing

Repair System Description: 50 to 60 lin ft panel

Maintenance Agreement Required ☐ YES ☐ NO

☐ GRAVITY ☐ PRESSURE

☐ Residence No. Bedrooms 3

☐ Business No. Persons

☐ Other No. Employees

☐ Slab ☐ Crawl Space

☐ Basement w/plumbing ☐ Basement w/o plumbing

Water Supply: ☐ Private ☐ Public ☐ Community


Comments / Conditions

At time of inspector system was not functioning N/C

Comments / Conditions

INITIAL SITE SKETCH

AS BUILT SKETCH

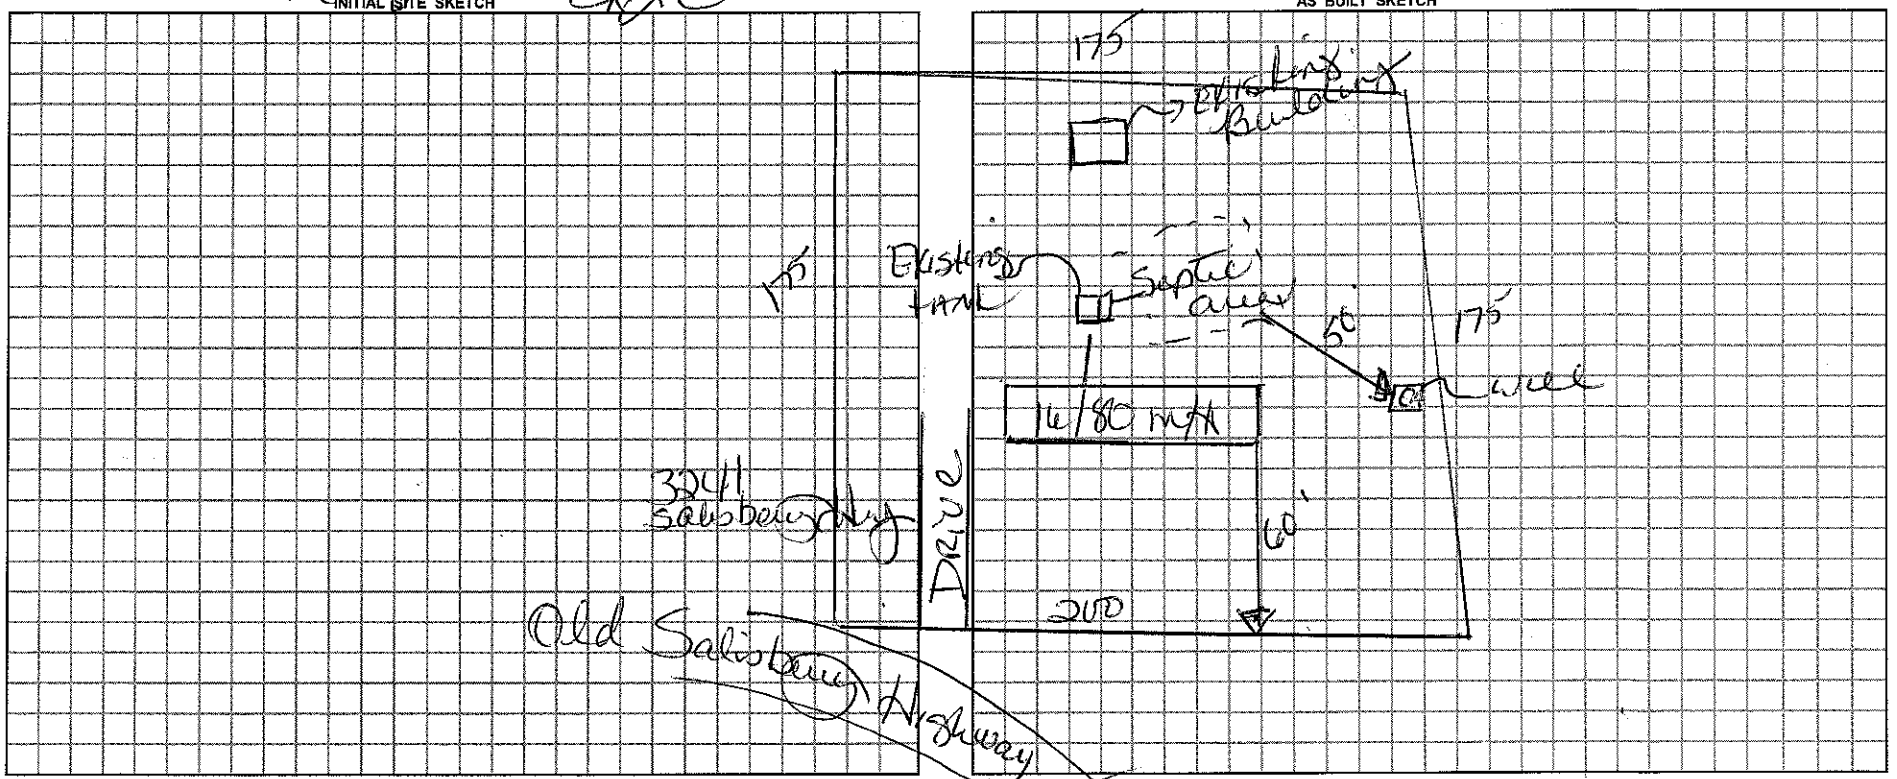

Permit can be suspended or revoked if any false information is supplied toward securing the permit / any unauthorized changes are made to the site / any unauthorized changes are made in the installation of the system.

☐ *IMPROVEMENT PERMIT w / plat valid without expiration.* ☐ *IMPROVEMENT PERMIT w / site plan valid for 60 mos.* ☑ *AUTHORIZATION TO CONSTRUCT valid for period equal to IMPROVEMENT PERMIT-not to exceed 60 mo.*

Owner / Applicant Signature: Date

Improvement Permit by: Date

Authorzation to Construct by: Date

YOU SHOULD CONTACT A LOCATOR SERVICE PRIOR TO ANY EXCAVATION.

Installed by:

Operation Permit by: Date:

Existing System Inspected by: Date: 3-26-09

WHITE COPY Environmental Health YELLOW COPY (Final) Owner / Applicant PINK COPY (Initial) Owner / Applicant