IREDELL COUNTY HEALTH DEPARTMENT

STATESVILLE 704-878-5305 MOORESVILLE 704-664-5281

IMPROVEMENT PERMIT / AUTHORIZATION TO CONSTRUCT / OPERATION PERMIT / EXISTING SYSTEM INSPECTION

PERMIT# 90453 PIN# 4783087418 DATE 9-14-00

OWNER OR CONTRACTOR Donnie Haley PHONE: Business Home 873 7097

ADDRESS 778 Elmwood Rd Statesville, N.C.

LOCATION 64 E TR Barry Oak Rd TR Elmwood 2mi Rt.

SUBDIVISION BLOCK / SECTION LOT LOT AREA 20 acres SITE CLASS P3 DESIGN FLOW 360 L.T.A.R. .2

Septic Tank: 1000 Gallons; STB 1012 Date 10-1-2000
Pump Tank: 1000 Gallons; PT 1017 Date 10-10-2000
Pump Make: Gould Model WE07H2H Serial No. K008203
Nitrification Field: No Fields 1 Square Feet 1800 Linear Feet 600
No Lines 6 Trench Width 36" Max Trench Bottom Depth 36" Gravel Depth 12"

☑ New System ☐ Repair System Type: I. II. III. IV. V. VI
System Description: Pump To Conv. Lines
Repair System Description: " " " "
Maintenance Agreement Required: ☐ Yes ☑ No

☐ House/Mod. Home ☐ Mobile Home ☐ Business ☐ Other
No. Bedrooms 3 No. Bathrooms 2 1/2 No. Employees


☐ Slab ☑ Crawl Space ☐ Basement w/plumbing ☐ Basement wo/plumbing

Water Supply: ☑ Individual ☐ Public ☐ Community


Comments/Conditions:
See Attached Drawings for Pump Tank Setup & Pressure manifold

Comments/Conditions: SYSTEM INSTALLED AS SHOWN WITH POLYLOK FILTER & RISERS

INITIAL SITE SKETCH

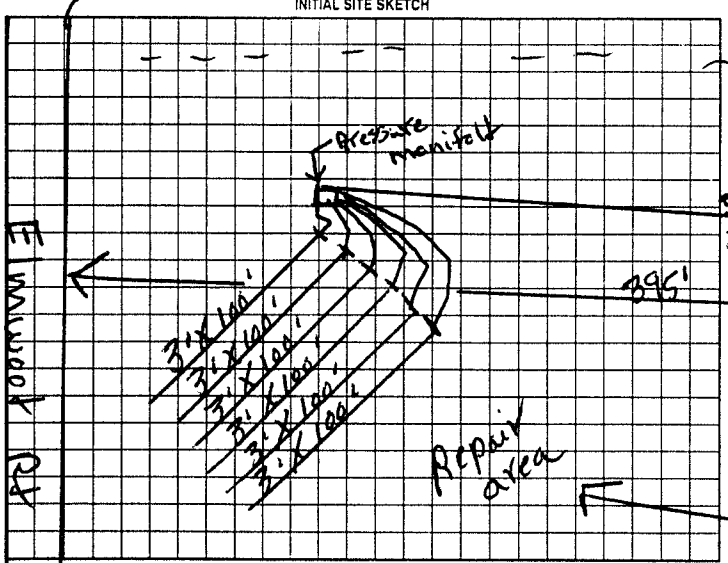

AS BUILT SKETCH

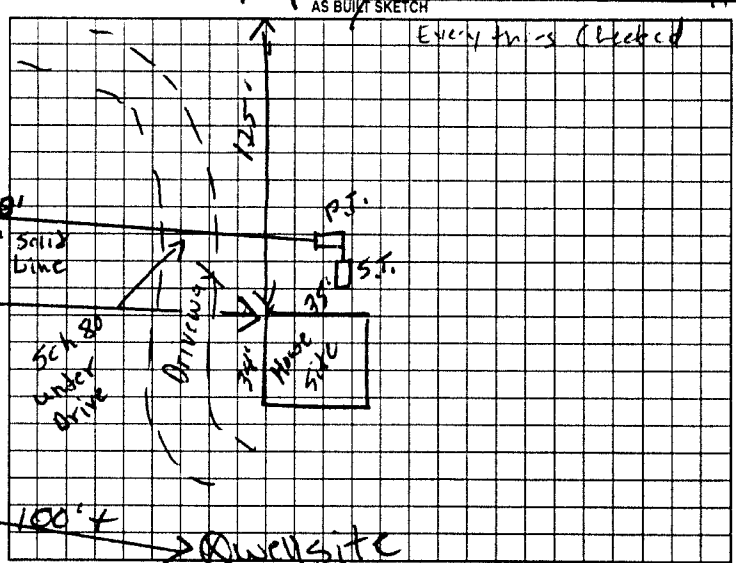

Permit can be suspended or revoked if any false information is supplied toward securing the permit/any unauthorized changes are made to the site/any unauthorized changes are made in the installation of the system. Improvement Permit with plat valid without expiration. Improvement Permit with site plan valid for sixty months. Authorization to Construct is valid for a period equal to that of Improvement Permit – not to exceed sixty months.

Signed: Donnie Haley date 9-20-00 Installed by: YOUNTZ GRADING

Improvement Permit by: J.C. Moore date 9-14-00 Operation Permit by: Jim Cook RSI date 3-28-01

Authorization to Construct by: J.C. Moore date 9-14-00 Existing System Inspection by: date

HEALTH DEPT. COPY: WHITE OWNER COPY (FINAL): YELLOW OWNER COPY (INITIAL): PINK